

HARRISON
 # G261
 1-7-78

MISSISSIPPI
 BOARD OF WATER COMMISSIONERS
 416 North State Street
 Jackson, Mississippi 39201

CODED

WATER WELL DRILLERS LOG

Jan 7 1978 McGill Well Works Harrison
 date well completed firm name county well located

LANDOWNER: Alton Bellwood
Expt. Mo.
 (mailing address)

WELL LOCATION:
 sec. 24 T-6 N R-12 E
2 miles E of Lyman
 (distance) (direction) (nearest town)

WELL PURPOSE: home
 (home, irrigation, municipal, industrial)

WELL COMPLETION DATA:

(1) diameter (inches) 2"
 (2) total depth (feet) 420
 (3) static water level (feet) 31 below above top of ground.
 (4) casing PIC-540 410
 (material) (depth)
 (size) If telescope see back.
 (5) screen 10' -
 (length) (depth to top)
2" plastic
 (size) (material)
 (6) pump 1 12
 (HP) (yield gpm)
electric
 (type power)
 (7) electric log no
 (yes or no)
 (organization running log)
 (8) how well bottom plugged sand
mark

description of formations encountered	from	to
clay	0	20
sand	20	87
B. clay	87	231
C. sand	231	260
B. clay	260	380
C. sand	380	400
B. sand	400	420

CODED

RECEIVED


AUG 11 1978

DRILLERS REMARKS:

MISS. RD. OF WATER COMM.

If well telescopes please sketch and show depths.

GROUND LEVEL

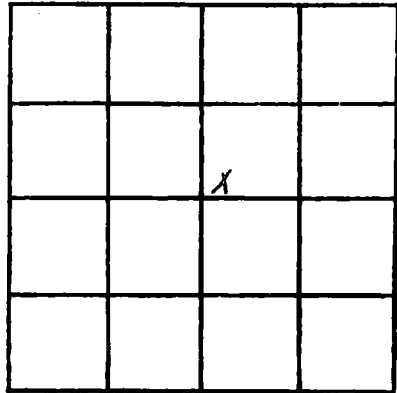

SECTION 24

Please indicate well location X.

ADDITIONAL INFORMATION

If more than one screen, show locations of each on sketch.