

HARRISON
G 264
9-4-75

MISSISSIPPI
 BOARD OF WATER COMMISSIONERS
 416 North State Street
 Jackson, Mississippi 39201

CODED

WATER WELL DRILLERS LOG

COASTAL DRILLING & SERVICE CO *Hamlin*

9/4 19*75*
 date well completed

ROUTE name **BOX 618**

county well located

LANDOWNER *Jim Mabley*

BILOXI, MISS 39537

description of formations encountered

from to

RT 3 Box 155
Lpt, Min
 (mailing address)

<i>Top Soil</i>	<i>1</i>	<i>2</i>
<i>Red Clay</i>	<i>2</i>	<i>15</i>
<i>White Sand</i>	<i>15</i>	<i>230</i>
<i>Soft Blue Clay</i>	<i>230</i>	<i>300</i>
<i>fine water sand</i>	<i>300</i>	<i>320</i>
<i>hard blue clay</i>	<i>320</i>	<i>420</i>
<i>fine water sand</i>	<i>420</i>	<i>440</i>
<i>Coarse water sand</i>	<i>440</i>	<i>480</i>

WELL LOCATION:

sec *17* T *6* N R *11* E
1/2 miles *E* of *Fish Hatchery*
 (distance) (direction) (nearest town)

WELL PURPOSE: *Transect Park*
 (home, irrigation, municipal, industrial)

CODED


WELL COMPLETION DATA:

- (1) diameter (inches) *4 1/2"*
- (2) total depth (feet) *480'*
- (3) static water level (feet) *20* below top of ground
- (4) casing *Galv* *460'*
 (material) (depth)
4 1/2" If telescope see back.
 (size)
- (5) screen *20'* *460'*
 (length) (depth to top)
2" *S.S.*
 (size) (material)
- (6) pump *2 1/2* *35*
 (HP) (yield gpm)
5 hp
 (type power)
- (7) electric log *No*
 (yes or no)

(organization running log)

(8) how well bottom plugged
Shack Wash Valve

DRILLERS REMARKS:
None

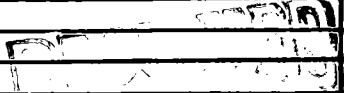

MAR 17 1976

If well telescopes please sketch and show depths.

GROUND LEVEL

			X

SECTION _____

Please indicate well location X.

ADDITIONAL INFORMATION

If more than one screen, show locations of each on sketch.