

HARR
G 265
11-15-75

MISSISSIPPI
BOARD OF WATER COMMISSIONERS
416 North State Street
Jackson, Mississippi 39201

CODED

WATER WELL DRILLERS LOG

11/15/75 date well completed 13 5 COASTAL DRILLING & SERVICE CO *Harrison* county well located
ROUTE 1 firm BOX 618

LANDOWNER: *Mr. A. Holloman*
Rt 5
Hart, Miss
(mailing address)

WELL LOCATION:
sec. *2* T. *6* N. R. *11* E. S. *5* W.
Fruit Ch. of
(distance) (direction) (nearest town)

WELL PURPOSE: *Home*
(home, irrigation, municipal, industrial)

- WELL COMPLETION DATA:
- (1) diameter (Inches) *2"*
 - (2) total depth (feet) *630'*
 - (3) static water level (feet) *38* below above top of ground.
 - (4) casing *PVC*, *620'*
(material) (depth)
(size) if telescope see back.
 - (5) screen *10'*, *620'*
(length) (depth to top)
2", *PVC*
(size) (material)
 - (6) pump *One*, *14*
(HP) (yield gpm)
Elle
(type power)
 - (7) electric log *No*
(yes or no)
- (organization running log)

description of formations encountered	from	to
<i>Top Soil</i>	<i>1</i>	<i>3</i>
<i>Red Clay</i>	<i>3</i>	<i>35</i>
<i>white Sand</i>	<i>35</i>	<i>60</i>
<i>Soft Blue Clay</i>	<i>60</i>	<i>190</i>
<i>fine water Sand</i>	<i>190</i>	<i>220</i>
<i>Hard Blue Clay</i>	<i>220</i>	<i>360</i>
<i>fine water Sand</i>	<i>360</i>	<i>385</i>
<i>Soft Brown Clay</i>	<i>385</i>	<i>395</i>
<i>Hard Blue Clay</i>	<i>395</i>	<i>520</i>
<i>fine water Sand</i>	<i>520</i>	<i>570</i>
<i>Coarse water Sand</i>	<i>570</i>	<i>630</i>


CODED

(8) how well bottom plugged
2" horizontal valve

DRILLERS REMARKS:
nm

If well telescopes please sketch and show depths.

GROUND LEVEL

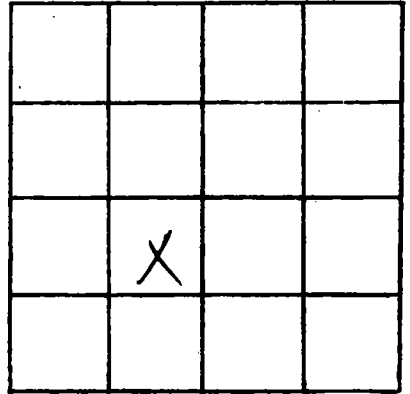

SECTION _____

Please indicate well location X.

ADDITIONAL INFORMATION

Lined area for additional information.

If more than one screen, show locations of each on sketch.