

HARRISON
G 267
12-21-75

MISSISSIPPI
 BOARD OF WATER COMMISSIONERS
 416 North State Street
 Jackson, Mississippi 39201

CODED

WATER WELL DRILLERS LOG

12-21-75 date well completed 1975 *Mc Hill Well Works* firm name *Harrison* county well located

LANDOWNER *J.H. Mc Onteque*
Rt. 2, Box 180
Gulf, Miss.
 (mailing address)

description of formations encountered	from	to
	<i>White sand clay</i>	<i>0</i>
<i>Red sand</i>	<i>48</i>	<i>78</i>
<i>Bluish</i>	<i>78</i>	<i>98</i>
<i>fine sand</i>	<i>98</i>	<i>131</i>
<i>Blue clay</i>	<i>131</i>	<i>187</i>
<i>fine sand</i>	<i>187</i>	<i>218</i>
<i>Bluish</i>	<i>218</i>	<i>261</i>
<i>fine sand</i>	<i>261</i>	<i>289</i>
<i>Blue clay</i>	<i>289</i>	<i>314</i>
<i>fine sand</i>	<i>314</i>	<i>361</i>
<i>Blue clay</i>	<i>361</i>	<i>381</i>
<i>Coarse sand</i>	<i>381</i>	<i>406</i>

WELL LOCATION:
 sec. *28* T. *6* N. R. *11* E.
3 miles *S.E.* of *Thymon*
 (distance) (direction) (nearest town)

WELL PURPOSE: *Home*
 (home, irrigation, municipal, industrial)

- WELL COMPLETION DATA:
- (1) diameter (inches) 2"
 - (2) total depth (feet) 406
 - (3) static water level (feet) 61 below above top of ground.
 - (4) casing sch 40 pipe
 (material) (depth)
2" If telescope see back.
 (size)
 - (5) screen 10
 (length) (depth to top)
2" SS.
 (size) (material)
 - (6) pump did not
 (HP) (yield gpm)
install
 (type power)
 - (7) electric log no
 (yes or no)
no
 (organization running log)
 - (8) how well bottom plugged good
shack

CODED


INDEXED
APR - 8 1975

DRILLERS REMARKS:

MISS. BD. OF WATER COM.

If well telescopes please sketch and show depths.

GROUND LEVEL

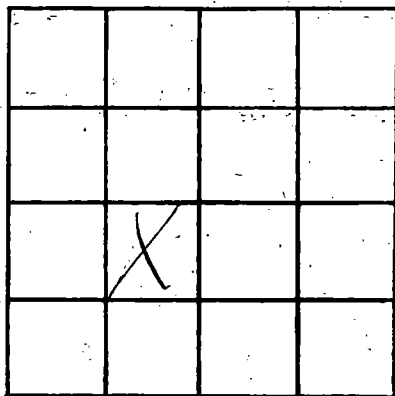

SECTION 28

Please indicate well location X.

ADDITIONAL INFORMATION

If more than one screen, show locations of each on sketch.