

HARRISON
G 268
3-13-76

MISSISSIPPI
 BOARD OF WATER COMMISSIONERS
 416 North State Street
 Jackson, Mississippi 39201


CODED

WATER WELL DRILLERS LOG

13 March 1976 RAYENT WELL CO HARRISON
 date well completed firm name county well located

LANDOWNER: <u>FRED WEAVER</u>	description of formations encountered	from	to
<u>RT 5 Box 571</u>			
<u>Gudspont Ms. 39501</u> (mailing address)	<u>sand</u>	<u>9</u>	<u>12</u>
WELL LOCATION:	<u>clay</u>	<u>12</u>	<u>55</u>
<u>sec. 36 T 6 R 11 S W</u>	<u>sand</u>	<u>55</u>	<u>76</u>
<u>5</u> miles <u>N</u> of <u>Gudspont</u>	<u>clay</u>	<u>76</u>	<u>237</u>
(distance) (direction) (nearest town)	<u>Good sand</u>	<u>237</u>	<u>279</u>
WELL PURPOSE: (home, irrigation, municipal, industrial)			
WELL COMPLETION DATA:			
(1) diameter (inches) <u>2</u>			
(2) total depth (feet) <u>279</u>			
(3) static water level (feet) <u>27</u> below/above top of ground.			
(4) casing <u>PVC</u> , <u>274</u> , (material) (depth)			
<u> </u> If telescope see back. (size)			
(5) screen <u>5'</u> , <u>274</u> (length) (depth to top)			
<u>PPG</u> , <u>PVC</u> (size) (material)			
(6) pump <u>1</u> , <u>12</u> (HP) (yield gpm)			
<u>ELECT</u> (type power)			
(7) electric log <u>NO</u> (yes or no)			
<u> </u> (organization running log)			
(8) how well bottom plugged <u>Metal</u> <u>sand sacks</u>			
REMARKS: <u> </u>			

CODED

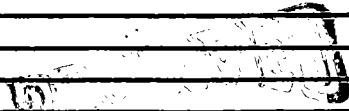


MAY - 6 1976

MISS. BD. OF WATER COMM.

If well telescopes please sketch and show depths.

GROUND LEVEL

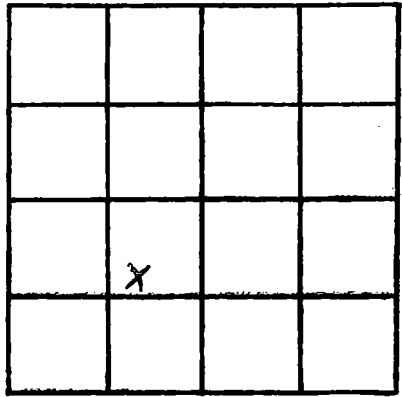

SECTION 36

Please indicate well location X.

ADDITIONAL INFORMATION

If more than one screen,
show locations of each on sketch.