

HARRISON
G 269
3-24-76

MISSISSIPPI
BOARD OF WATER COMMISSIONERS
416 North State Street
Jackson, Mississippi 39201

CODED

WATER WELL DRILLERS LOG

3-24 1976 date well completed
Mr B Drilling Co. firm name
Harrison county well located

LANDOWNER: Taha Braden
P.O. Box 489
Sauvier, Miss.
(mailing address)

description of formations encountered	from	to
Surface Clay	0	8
Red Clay	8	16
Sand	16	30
Sand & Clay	30	45
White Clay	45	70
Blue Clay	70	100
Sand	100	136
Blue Clay	136	+

WELL LOCATION:
sec. 8 T. 6 S. R. 11 E.
2 miles N of Lyman
(distance) (direction) (nearest town)

WELL PURPOSE: Home
(home, irrigation, municipal, industrial)

CODED


WELL COMPLETION DATA:

- (1) diameter (inches) 4"
- (2) total depth (feet) 136
- (3) static water level (feet) 24 below above top of ground.
- (4) casing (material) PVC, (depth) 136.
4" (size) if telescope see back.
- (5) screen (length) 125, (depth to top) 124.
4" (size), PVC Sand Pac (material)
- (6) pump 1 (HP), 22 (yield gpm).
220V (type power)
- (7) electric log No (yes or no)

(organization running log)

(8) how well bottom plugged
2" Back Wash Valve

DRILLERS REMARKS:

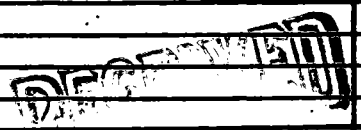

APR 17 1976

WATER COMMISSION

If well telescopes please sketch and show depths.

GROUND LEVEL

X			

SECTION 8

Please indicate well location X.

ADDITIONAL INFORMATION

If more than one screen, show locations of each on sketch.