

**HARRISON**  
**G 270**  
**3-31-76**

**MISSISSIPPI**  
**BOARD OF WATER COMMISSIONERS**  
 416 North State Street  
 Jackson, Mississippi 39201

**CODED**

**WATER WELL DRILLERS LOG**

March 31 1976 M & B Drilling Co. Harrison  
 date well completed firm name county well located

**LANDOWNER:**  
Carroll Peterson  
Lyman, Miss.  
 (mailing address)

**WELL LOCATION:**  
 sec 29 T 6 S R 11 W  
7 miles (distance) of Lyman (nearest town)

**WELL PURPOSE:** Home  
 (home, irrigation, municipal, industrial)

**WELL COMPLETION DATA:**

(1) diameter (inches) 4 1/2 x 2 1/2

(2) total depth (feet) 690

(3) static water level (feet) 75 below above top of ground.

(4) casing PVC Total  
 (material) (depth)  
4 1/2 if telescope see back.  
 (size)

(5) screen 10 FT 680  
 (length) (depth to top)  
2" PVC  
 (size) (material)


(6) pump 1 8  
 (HP) (yield gpm)  
200V 10  
 (type power)

(7) electric log No  
 (yes or no)

(organization running log)

description of formations encountered	from	to
Surface Clay	0	12
Red Clay	12	18
Sand	18	28
White Clay	28	68
Grey Clay	68	80
Blue Clay	85	145
Sand	145	152
Blue Clay	152	280
Sand	280	290
Blue Clay	290	420
Sand	420	545
Blue Clay	545	630
Sand	630	690
Blue Clay	690	+

**CODED**

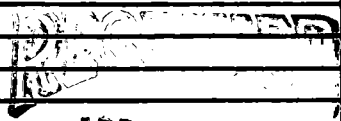

APR 19 1976


(8) how well bottom plugged  
2 1/2" Back Wash Check

**DRILLERS REMARKS:**

MISS. BD. OF WATER COMM

If well telescopes please sketch and show depths.

GROUND LEVEL

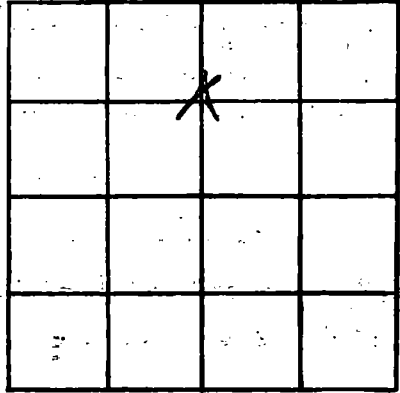

SECTION 29

Please indicate well location X.

ADDITIONAL INFORMATION

Multiple horizontal lines for writing additional information.

If more than one screen, show locations of each on sketch.