

HARRISON  
G 271  
4-12-76

MISSISSIPPI  
BOARD OF WATER COMMISSIONERS  
416 North State Street  
Jackson, Mississippi 39201

CODED

WATER WELL DRILLERS LOG

April 12 1976 Max B. Wilby Co Harrison  
date well completed firm name county well located

LANDOWNER: Walter Neerer  
John Clark Rd.  
Cullport, Miss.  
(mailing address)

WELL LOCATION:  
sec 31 T 6 S R 11 E  
2 miles W of Nugent  
(distance) (direction) (nearest town)

WELL PURPOSE: None  
(home, irrigation, municipal, industrial)

- WELL COMPLETION DATA:
- (1) diameter (inches) 2
  - (2) total depth (feet) 525
  - (3) static water level (feet) 60 below above top of ground.
  - (4) casing pvc Total  
(material) (depth)  
2" if telescope see back.  
(size)
  - (5) screen 10ft 515  
(length) (depth to top)  
2" pvc  
(size) (material)
  - (6) pump 1 8  
(HP) (yield gpm)  
220V 1Ø  
(type power)
  - (7) electric log No  
(yes or no)
- (organization running log)
- (8) how well bottom plugged  
2" Back Wash Valve

| description of formations encountered | from to |     |
|---------------------------------------|---------|-----|
|                                       |         |     |
| Surface                               | 0       | 3   |
| Brown Clay                            | 3       | 12  |
| Sand                                  | 12      | 18  |
| Red Clay                              | 18      | 30  |
| White Sand                            | 30      | 25  |
| White Clay                            | 25      | 120 |
| Grey Clay                             | 120     | 128 |
| Sand                                  | 128     | 194 |
| Blue Clay                             | 194     | 180 |
| Grey Sand                             | 180     | 525 |
| Blue Clay                             | 525     | +   |

CODED


RECEIVED  
APR 19 1976

MISS. BD. OF WATER COMM

DRILLERS REMARKS:

If well telescopes please sketch and show depths.

GROUND LEVEL

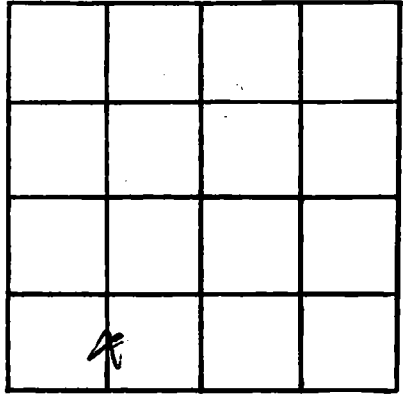

SECTION 31

Please indicate well location X.

ADDITIONAL INFORMATION

If more than one screen, show locations of each on sketch.