

HARRISON
G 278
7-2-76

MISSISSIPPI
 BOARD OF WATER COMMISSIONERS
 416 North State Street
 Jackson, Mississippi 39201

CODED

WATER WELL DRILLERS LOG

July 2 1976 Bryant Well Co. HARRISON
 date well completed firm name county well located

LANDOWNER: <u>FRANK Whiston</u>	Description of formations encountered	from	to
<u>Old Hwy 49</u>	<u>Clay</u>	<u>0</u>	<u>17</u>
<u>Saucier, MS</u> (mailing address)	<u>sand</u>	<u>17</u>	<u>36</u>
WELL LOCATION:	<u>fine sand</u>	<u>36</u>	<u>51</u>
sec. <u>6</u> T. <u>6</u> N. R. <u>11</u> W.	<u>Blue Clay</u>	<u>51</u>	<u>126</u>
<u>9</u> miles <u>N</u> of <u>Gulfport</u>	<u>good sand</u>	<u>126</u>	<u>151</u>
(distance) (direction) (nearest town)			
WELL PURPOSE: <u>Home</u> (home, irrigation, municipal, industrial)			
WELL COMPLETION DATA:			
(1) diameter (inches) <u>2 1/2</u>			
(2) total depth (feet) <u>251</u>			
(3) static water level (feet) _____ below above top of ground.			
(4) casing <u>PVC</u> , <u>251</u> , (material) (depth)			
_____ If telescope see back. (size)			
(5) screen <u>5</u> , <u>246</u> (length) (depth to top)			
<u>009</u> , <u>PVC</u> (size) (material)			
(6) pump _____ (HP) (yield gpm)			
(type power)			
(7) electric log <u>NO</u> (yes or no)			
(organization running log)			
(8) how well bottom plugged <u>SAND</u> <u>SHARK</u>			
DRILLERS REMARKS:			
<u>Drilled by C.M. Bryant Jr</u>			


CODED

RECEIVED
 JUL 15 1976

MISS. Bd. OF WATER COMM.

If well telescopes please sketch and show depths.

GROUND LEVEL

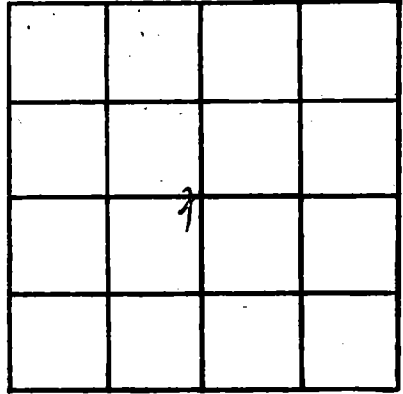

SECTION 1

Please indicate well location X.

ADDITIONAL INFORMATION

If more than one screen, show locations of each on sketch.