

HARRISON
G 282
1-20-77

MISSISSIPPI
 BOARD OF WATER COMMISSIONERS
 416 North State Street
 Jackson, Mississippi 39201

CODED

WATER WELL DRILLERS LOG
 COASTAL DRILLING & SERVICE CO.

1/20
 date well completed

1977
 ROUTE 1 BOX 618
 Biloxi, Miss.

Harrison
 county well located

LANDOWNER: **T.A. [unclear]**

description of formations encountered

from to

pt 3
447 min
 (mailing address)

top soil	1	3
red clay	3	15
white sand & gravel	15	40
gray sand	40	65
soft blue clay	65	120
gray sand	120	160
soft blue clay	160	310
fine water sand	310	340
hard blue clay	340	425
fine water sand	425	435
coarse water sand	435	470

WELL LOCATION:

sec **36 T 6 N R 11 E**
Three Rivers Estate
 (distance) (direction) (nearest town)

WELL PURPOSE: **private use**
 (home, irrigation, municipal, industrial)

WELL COMPLETION DATA:

- (1) diameter (inches) **4 1/2"**
 - (2) total depth (feet) **470'**
 - (3) static water level (feet) **35'** below top of ground.
 - (4) casing **PVC, 455'**
 (material) (depth)
4 1/2" If telescope see back.
 (size)
 - (5) screen **15', 455'**
 (length) (depth to top)
2" (size) **PVC** (material)
 - (6) pump **One 20**
 (HP) (yield gpm)
Electric (type power)
 - (7) electric log **no**
 (yes or no)
- (organization running log)

CODED

(8) how well bottom plugged

2" bentonite seal

DRILLERS REMARKS:

Very good well

RECEIVED
APR 4 1977

MISS. Bd. OF WATER COMM

If well telescopes please sketch and show depths.

GROUND LEVEL


153 ft 4" PVC
Casing

30 ft 2" PVC
Casing

15' 2" PVC Screen

~~2" PVC Screen~~
back Wash Valve

If more than one screen,
show locations of each on sketch.

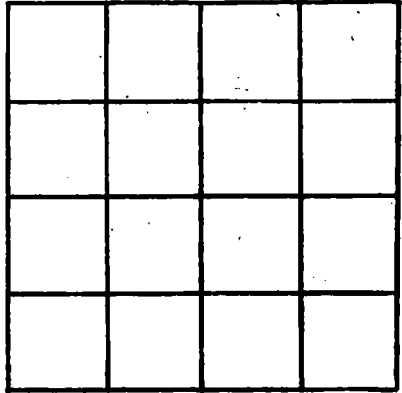

SECTION _____

Please indicate well location X.

ADDITIONAL INFORMATION

Horizontal lines for additional information.