

HARRISON
G283

MISSISSIPPI
BOARD OF WATER COMMISSIONERS
416 North State Street
Jackson, Mississippi 39201

CODED

WATER WELL DRILLERS LOG

JUNE 23 1977 J+B Well Co HARRISON
date well completed firm name county well located

TC L&D NEK 8-1

LANDOWNER: ROBERT STEVENS
BILOXI RIVER
Rt BRANK ACRES
GULFPORT
(mailing address)

WELL LOCATION:
26 Block 5
sec. T 6 N R. 11 E
BILOXI RIVER
RALLY ARTISES ESTATES
(distance) (direction) (nearest town)

WELL PURPOSE:
(home, irrigation, municipal, industrial)

- WELL COMPLETION DATA:
- (1) diameter (inches) 2
 - (2) total depth (feet) 71-9
 - (3) static water level (feet) 12 below
top of ground.
 - (4) casing PLASTIC 60
(material) (depth)
2 if telescope see back.
(size)
 - (5) screen 11-9, 60
(length) (depth to top)
2, PLASTIC
(size) (material)
 - (6) pump 1 105
(HP) (yield gpm)
ELEC
(type power)
 - (7) electric log yes (no)
 - (8) how well bottom plugged CAPPED

DRILLERS REMARKS:

description of formations encountered	from	to
TOP SOIL	0	
CLAY	0	10
CLAY & SAND	10	20
SAND RED	20	30
SAND-RED	30	32
3" CLAY	32	
SAND RED	32	40
SAND WHITE	40	50
SAND WHITE	50	60
SAND - WHITE	60	71-9
CLAY Bottom	71-9	


CODED

RECEIVED

MISSISSIPPI BOARD OF WATER COMM

If well telescopes please sketch and show depths.

GROUND LEVEL

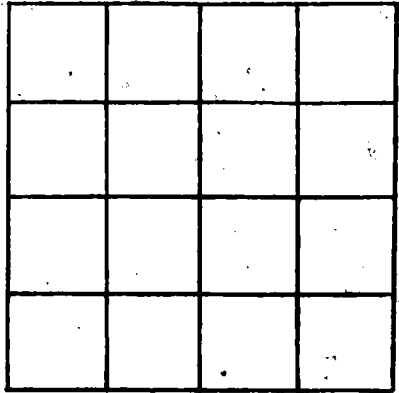

SECTION _____

Please indicate well location X.

ADDITIONAL INFORMATION

If more than one screen, show locations of each on sketch.