

Harrison
 5287
 8/22/77

MISSISSIPPI
 BOARD OF WATER COMMISSIONERS
 416 North State Street
 Jackson, Mississippi 39201

CODED

WATER WELL DRILLERS LOG

8/22/77 19 Central Drilling Harrison
 date well completed firm name county well located
Bilbo, Miss.

LANDOWNER: Paul Palmer
John Clark Rd
Apt. Miss
 (mailing address)

| description of formations encountered | from | to |
|---------------------------------------|------|-----|
| top soil | 1 | 3 |
| Soft Red Clay | 3 | 15 |
| Sugar Sand | 15 | 40 |
| Coarse white sand | 40 | 60 |
| Soft Blue Clay | 60 | 150 |
| fine water sand | 150 | 200 |
| Soft Blue Clay | 200 | 275 |
| hard blue clay | 275 | 310 |
| fine water sand | 310 | 330 |
| Hard Blue Clay | 330 | 400 |
| fine water sand | 400 | 485 |
| Coarse good water sand | 485 | 525 |

WELL LOCATION:
 sec. 32 T. 6 N R. 11 E
S W
(2) Two South Lyon
 (distance) (direction) (nearest town)

WELL PURPOSE: None
 (home, irrigation, municipal, industrial)

WELL COMPLETION DATA:
 (1) diameter (inches) 4 1/2"
 (2) total depth (feet) 525'
 (3) static water level (feet) 55' below top of ground.
 (4) casing PVC 510'
 (material) (depth)
4 1/2" If telescope see back.
 (size)
 (5) screen 15' 510'
 (length) (depth to top)
2" PVC
 (size) (material)
 (6) pump One Sub 50
 (HP) (yield gpm)
5hp
 (type power)
 (7) electric log no
 (yes or no)

(organization running log)
 (8) how well bottom plugged
2" backwash valve
 DRILLERS REMARKS:

CODED

RECEIVED

DEC 29 1977

MISS. BD. OF WATER COMM

If well telescopes please sketch and show depths.

GROUND LEVEL


160' 4" PVC Casing

350' 2" PVC Casing

15' 2" PVC Screen

2" back wash valve
B-19

If more than one screen, show locations of each on sketch.

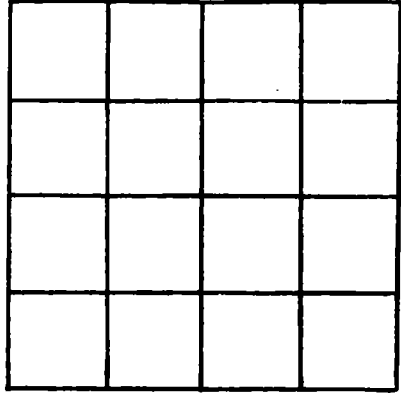

SECTION _____

Please indicate well location X.

ADDITIONAL INFORMATION

A series of horizontal lines for recording additional information, starting below the 'ADDITIONAL INFORMATION' header and extending to the bottom of the page.