

Harrison
 15292
 12/6/77

MISSISSIPPI
 BOARD OF WATER COMMISSIONERS
 416 North State Street
 Jackson, Mississippi 39201

CODED

WATER WELL DRILLERS LOG

12/6/77 19 Central Drilling Harrison
 date well completed Bml name county well located

LANDOWNER: John Hatten
Rt 6 238 Ashwood
Gpt, Miss 39501
 (mailing address)

| description of formations encountered | from | to |
|---------------------------------------|------|-----|
| top soil | 1 | 3 |
| Red Clay | 3 | 15 |
| Coarse white sand | 15 | 40 |
| Soft Blue Clay | 40 | 210 |
| fine water sand | 210 | 230 |
| Soft Blue Clay | 230 | 300 |
| Hard Blue Clay | 300 | 480 |
| fine water sand | 480 | 480 |
| Coarse white sand | 480 | 505 |

WELL LOCATION:
 sec. 22 T 6 N R. 11 W
2 1/2 miles NW Jayron
 (distance) (direction) (nearest town)

WELL PURPOSE: home
 (home, irrigation, municipal, industrial)

WELL COMPLETION DATA:

(1) diameter (inches) 4 1/2"

(2) total depth (feet) 505'

(3) static water level (feet) 55 below above top of ground.

(4) casing 4 1/2" 490'
 (material) (depth)
4 1/2" If telescope see back.
 (size)

(5) screen 15' 490'
 (length) (depth to top)
2" pcu
 (size) (material)

(6) pump One sub 20
 (HP) (yield gpm)
Ele
 (type power)

(7) electric log no
 (yes or no)

(organization running log)

CODED

(8) box well bottom plugged
2" beach (1/2) solid

DRILLERS REMARKS:

RECEIVED
 JAN 13 1978

MISS. BD. OF WATER COM

If well telescopes please sketch and show depths.

GROUND LEVEL


200ft 4" PVC
Casing

290' 2" PVC
Casing

15' 2" PVC
Screen

2" (back) Wash
Valve

If more than one screen,
show locations of each on sketch.

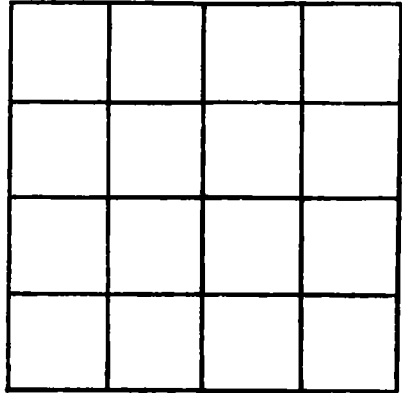

SECTION _____

Please indicate well location X.

ADDITIONAL INFORMATION

A series of horizontal lines for recording additional information, starting below the 'ADDITIONAL INFORMATION' header and extending to the bottom of the page.