

Harrison
 [G] 293
 3-3-78

MISSISSIPPI
 BOARD OF WATER COMMISSIONERS
 416 North State Street
 Jackson, Mississippi 39201

CODED

WATER WELL DRILLERS LOG

MARCH 3 1978 Boyant Well Co HARRISON
 date well completed firm name county well located

LANDOWNER: H. F. Stovall
147. Cahoon Dr.
201 Sport N.S. 3750.E
 (mailing address)

description of formations encountered	from	to
CLAY	0	31
SAND	31	57
CLAY	57	75
SAND	75	82
CLAY	82	140
SAND FIRST	140	160
CLAY	160	224
SAND	224	254
CLAY	254	277
GOOD SAND	277	360

WELL LOCATION:
 sec. 17 T. 6 N. R. 11 E.
14 miles NW of LYMAN
 (distance) (direction) (nearest town)

WELL PURPOSE: Home
 (home, irrigation, municipal, industrial)

WELL COMPLETION DATA:

(1) diameter (inches) 4 1/2

(2) total depth (feet) 360

(3) static water level (feet) 40 ^(below) _{above} top of ground.

(4) casing PVC (material), 55' (depth)
4 1/2" if telescope see back.
 (size)

(5) screen 15' (length), 300 (depth to top)
200 (size), PVC (material)

(6) pump _____ (HP) _____ (yield gpm)
 (type power)

(7) electric log _____ (yes or no)
 (organization running log)

(8) how well bottom plugged Method
ONE WELL

CODED

RECEIVED



MAR 13 1978

DRILLERS REMARKS:

MISS. BD. OF WATER COMM

If well telescopes please sketch and show depths.

GROUND LEVEL

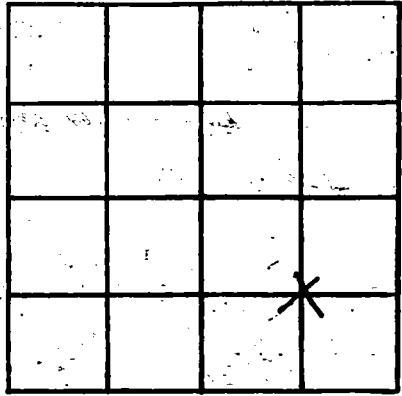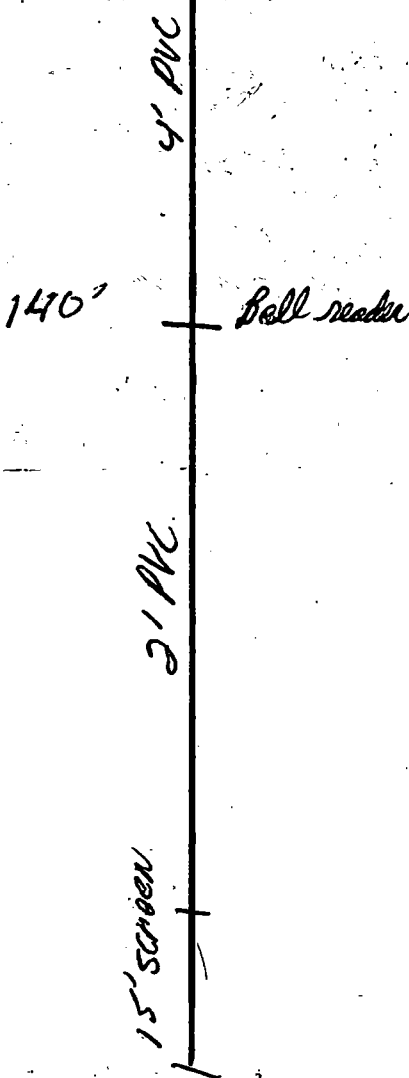

SECTION 19

Please indicate well location X.

ADDITIONAL INFORMATION

If more than one screen, show locations of each on sketch.