

HARRISON

G 296

5-3-78

MISSISSIPPI BOARD OF WATER COMMISSIONERS 416 North State Street Jackson, Mississippi 39201

CODED.

WATER WELL DRILLERS LOG

5/3/78 date well completed 19 Coastal Drillers firm name Harrison county well located Rt 1 Belzoni Miss

LANDOWNER: Roy Wilton

description of formations encountered from to

Rt 7 Gpt. Miss (mailing address)

Table with 3 columns: description of formations encountered, from, to. Rows include Top Soil, Red Clay, White Sand, Soft Blue Clay, fine water sand, Soft Blue Clay, hard Blue Clay, fine water sand, coarse water sand.

WELL LOCATION: sec 30 T 6 N R 11 E W 1/4 S 1/4 of Lyman (distance) (direction) (nearest town)

WELL PURPOSE: home (home, irrigation, municipal, industrial)

WELL COMPLETION DATA:

- (1) diameter (inches) 2"
(2) total depth (feet) 575'
(3) static water level (feet) 75 below top of ground.
(4) casing PVC 505' (material) (depth)
(5) screen 10' 505' (length) (depth to top)
(6) pump 1 1/2 HP 10 (type power) (yield gpm)
(7) electric log no (yes or no)

CODED

(organization running log)

(8) (has well bottom) plugged 2 back with talce

DRILLERS REMARKS:


RECEIVED

JUN 30 1978

MISS. RD. OF WATER COMM

If well telescopes please sketch and show depths.

GROUND LEVEL

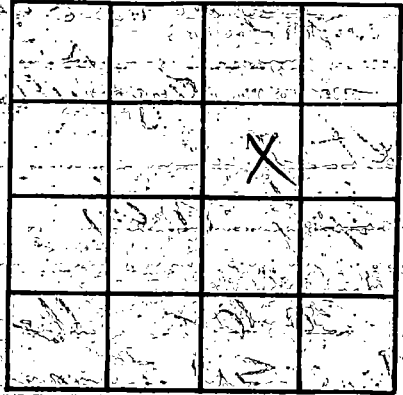

SECTION _____

Please indicate well location X.

ADDITIONAL INFORMATION

Multiple horizontal lines for writing additional information.

If more than one screen, show locations of each on sketch.