

HARRISON
G298
6-5-78

MISSISSIPPI
BOARD OF WATER COMMISSIONERS
416 North State Street
Jackson, Mississippi 39201

CODED

WATER WELL DRILLERS LOG

June 5 1978 *Sumner Well Drilling Harrison*
date well completed firm name county well located

LANDOWNER: *Mr. J. N. Purser*
Rt. 10 Box 377
Gulfport, Ms.
(mailing address)

description of formations encountered	from	to
<i>Clay</i>	<i>0</i>	<i>20</i>
<i>Sand</i>	<i>20</i>	<i>35</i>
<i>Blue Clay</i>	<i>35</i>	<i>160</i>
<i>Fine Sand</i>	<i>160</i>	<i>205</i>
<i>Coarse Sand</i>	<i>205</i>	<i>220</i>

WELL LOCATION:
sec. *33* T. *6* N. R. *10* E.
1/4 ? miles *E* of *Sumner*
(distance) (direction) (nearest town)

WELL PURPOSE: *Home*
(home, irrigation, municipal, industrial)

- WELL COMPLETION DATA:
- (1) diameter (inches) *2"*
 - (2) total depth (feet) *220ft.*
 - (3) static water level (feet) *60* ^{below} top of ground.
 - (4) casing *pvc* (material) *210'* (depth)
 - (5) screen *10'* (length) *210'* (depth to top)
2" (size) *pvc sch. 40* (material)
 - (6) pump *1* (HP) *12* (yield gpm)
electric (type power)
 - (7) electric log *No* (yes or no)

(organization running log)

(8) how well bottom plugged *Sand*
Shark

DRILLERS REMARKS:


CODED

RECEIVED
AUG 11 1978

MISS. BD. OF WATER COMM

If well telescopes please sketch and show depths.

GROUND LEVEL

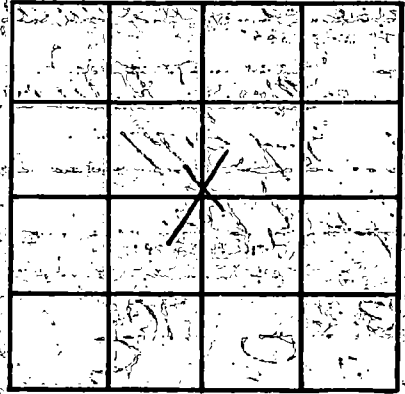

SECTION 33

Please indicate well location X.

ADDITIONAL INFORMATION

If more than one screen, show locations of each on sketch.