

HARRISON

G 307

8-10-78

MISSISSIPPI BOARD OF WATER COMMISSIONERS  
416 North State Street  
Jackson, Mississippi 39201

CODED

WATER WELL DRILLERS LOG

August 10 1978  
date well completed

Lyman Well Co.  
firm name

Harrison  
county well located

LANDOWNER:

Loy Peterman

Rt 3, North Swan Rd

Gulfport, MS 39503

(mailing address)

WELL LOCATION:

sec 21 T 6 N R 11 E  
7 miles <sup>North</sup> ~~South~~ of Gulfport  
(distance) (direction) (nearest town)

WELL PURPOSE:

Home  
(home, irrigation, municipal, industrial)

WELL COMPLETION DATA:

- (1) diameter (inches) two
- (2) total depth (feet) 230
- (3) static water level (feet) 60 <sup>below</sup> ~~above~~ top of ground.
- (4) casing P.V.C., 210,  
(material) (depth)  
2 in if telescope see back.  
(size)
- (5) screen 20 ft,  
(length) (depth to top)  
8 slot, P.V.C.  
(size) (material)
- (6) pump 1, 8  
(HP) (yield gpm)  
220 volt  
(type power)
- (7) electric log no  
(yes or no)

(organization running log)

(8) how well bottom plugged sand  
shark

description of formations encountered

from to

red clay	0	12
sand orange	12	18
clay white	18	58
sand salt & pepper	58	67
clay grey-blue	67	190
sand salt & pepper	190	230

CODED

RECEIVED


SEP 11 1978

DRILLERS REMARKS:

MISS. BD. OF WATER COMMISSIONERS

If well telescopes please sketch and show depths.

GROUND LEVEL

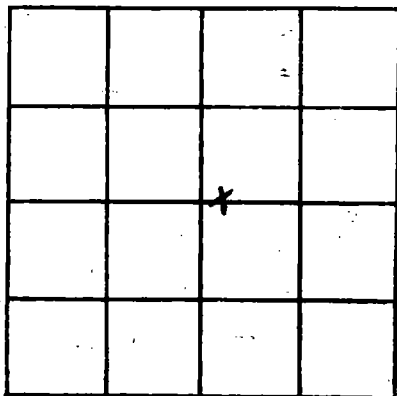

SECTION 21

Please indicate well location X.

ADDITIONAL INFORMATION

If more than one screen, show locations of each on sketch.