

HARRISON

G 308

11-19-78

MISSISSIPPI BOARD OF WATER COMMISSIONERS  
416 North State Street  
Jackson, Mississippi 39201

CODED

WATER WELL DRILLERS LOG

11-19-78

Lyman Well Co.

Harrison

date well completed

firm name

county well located

LANDOWNER: Dora Lowe  
Beaver St. Lyman  
Gulfport, Ms  
(milling address)

description of formations encountered	from	to
red+yellow clay	0	8
red sand	8	14
yellow clay	14	70
sand	70	90
gray clay	90	240
sandy clay	240	260
blue+gray clay	260	325
sand	325	360

WELL LOCATION:

sec. 19 T. 6 N. R. 11 E.  
10 miles N of Gulfport  
(distance) (direction) (nearest town)

WELL PURPOSE: home  
(home, irrigation, municipal, industrial)

CODED

WELL COMPLETION DATA:


- (1) diameter (inches) 2in
- (2) total depth (feet) 360
- (3) static water level (feet) 68 below top of ground
- (4) casing PVC 350 ft  
(material) (depth)  
2in (size) If telescope see back
- (5) screen 10 ft 350  
(length) (depth to top)  
2in 8 slot PVC  
(size) (material)
- (6) pump \_\_\_\_\_  
(HP) (yield gpm)  
(type power)
- (7) electric log \_\_\_\_\_  
(yes or no)  
(organization running log)
- (8) how well bottom plugged sand  
shank

DRILLERS REMARKS:

RECEIVED  
NOV 28 1978  
MISS. BD. OF WATER COMM.

If well telescopes please sketch and show depths.

GROUND LEVEL

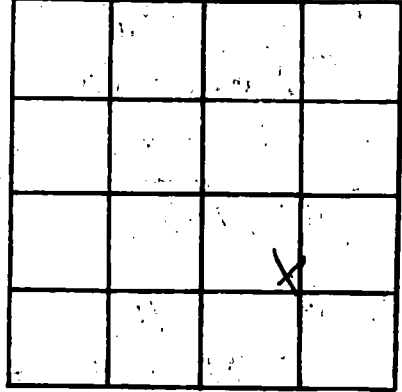

SECTION 19

Please indicate well location X.

ADDITIONAL INFORMATION

A series of horizontal lines for writing additional information, starting below the 'ADDITIONAL INFORMATION' header and extending down to the bottom of the page.

If more than one screen, show locations of each on sketch.