

Harrison
G 318

MISSISSIPPI
BOARD OF WATER COMMISSIONERS
416 North State Street
Jackson, Mississippi 39201

CODED

WATER WELL DRILLERS LOG

12-14 1979 Braden Pump & Well Service, Inc Harrison
date well completed firm name county well located

LANDOWNERS: Clarence Page
Rt. 3, Box 36
Mudport, MS 39208
(mailing address)

description of formations encountered	from	to
Red clay	0	40
Sand	40	100
Yellow clay	100	140
Blue clay	140	400
Sand	400	480

WELL LOCATION:
sec 28 T. 6 S. R. 11 W.
1/2 miles E of Lyman
(distance) (direction) (nearest town)

WELL PURPOSE: Home
(home, irrigation, municipal, industrial)

CODED


- WELL COMPLETION DATA:
- (1) diameter (inches) 2"
 - (2) total depth (feet) 480'
 - (3) static water level (feet) 56 below top of ground
 - (4) casing PVC total
(material) (depth)
2" (size) if telescope see back.
 - (5) screen 10' 470'
(length) (depth to top)
2" .008 PVC underdrain
(size) (material)
 - (6) pump 1 10
(HP) (yield gpm)
220 V 1Ø
(type power)
 - (7) electric log NO
(yes or no)
- (organization running log)
- (8) how well bottom plugged
2" sand sharp

DRILLERS REMARKS:
no tail pipe

DEPT. OF NATURAL RESOURCES
BUREAU OF LAND & WATER RESOURCES
JAN 17 1980
RECEIVED

If well telescopes please sketch and show depths.

GROUND LEVEL

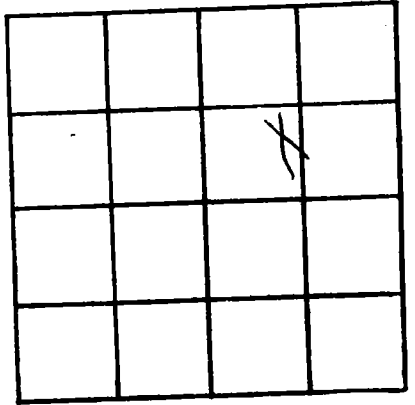

SECTION 28

Please indicate well location X.

ADDITIONAL INFORMATION

If more than one screen, show locations of each on sketch.