

HARRISON
 6319
 07-03-79

MISSISSIPPI
 BOARD OF WATER COMMISSIONERS
 416 North State Street
 Jackson, Mississippi 39201

CODED

WATER WELL DRILLERS LOG

July 3 1979 date well completed
 1519 Duncan Well Drilling firm name
 Harrison county well located

LANDOWNER: Robert McKay
 Rt. 10 Box 572-M
 Sheppard, Mo. 39503
 (mailing address)

description of formations encountered	from	to
Top Sand	0	35
white clay	35	98
Blue clay	98	270
fine sand	270	325
Coarser Sand	325	336

WELL LOCATION:
 sec 35 T 8 N R 11 E
 2 miles E of Nugeen
 (distance) (direction) (nearest town)

CODED

WELL PURPOSE: Home
 (home, irrigation, municipal, industrial)

- WELL COMPLETION DATA:
- (1) diameter (inches) 2"
 - (2) total depth (feet) 336 ft.
 - (3) static water level (feet) 60' below top of ground
 - (4) casing PVC, 326' (material) (depth)
 - (5) screen 10' 326' (length) (depth to top)
 2" (size) PVC (material)
 - (6) pump 1/2 HP 11 (HP) (yield gpm)
 electric (type power)
 - (7) electric log (yes or no)

(organization running log)

(8) how well bottom plugged Sand
 Sand

DEPT. OF NATURAL RESOURCES
 BUREAU OF LAND & WATER RESOURCES


JAN 14 1980

RECEIVED

DRILLERS REMARKS:

If well telescopes please sketch and show depths.

GROUND LEVEL

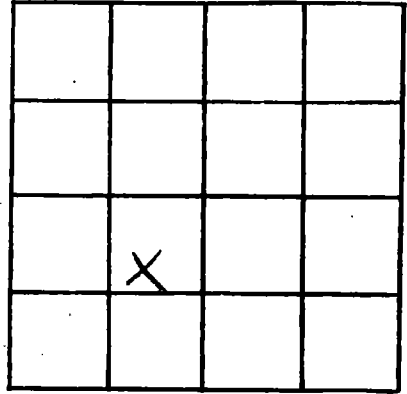

SECTION 35

Please indicate well location X.

ADDITIONAL INFORMATION

If more than one screen,
show locations of each on sketch.