

MISSISSIPPI  
BOARD OF WATER COMMISSIONERS  
416 North State Street  
Jackson, Mississippi 39201

CODED

WATER WELL DRILLERS LOG

HARRISON  
G 323  
1-18-80

1-18 1980 date well completed Braden Rump Well Harrison  
Service, Inc firm name county well located

LANDOWNER:  
Mike Holliman  
Rt. 5, Box 748-H  
Newport, MS  
(mailing address)

description of formations encountered	from	to
	clay sand	0 20

CODED

WELL LOCATION:  
sec. 36 T 10 S R 11 E W  
3 1/2 miles NW of Woolmarket  
(distance) (direction) (nearest town)

WELL PURPOSE: Home  
(home, irrigation, municipal, industrial)

- WELL COMPLETION DATA:
- (1) diameter (inches) 2"
  - (2) total depth (feet) 80'
  - (3) static water level (feet) 15 below top of ground.
  - (4) casing 2" PVC total (material) (depth)
  - 2" (size) If telescope see back.
  - (5) screen 5' 60' (length) (depth to top)
  - 2" PVC underbar (size) (material)
  - (6) pump 1 10 (HP) (yield gpm)
  - 110 (type power)
  - (7) electric log NO (yes or no)
  - (organization running log)

DEPT. OF NATURAL RESOURCES  
BUREAU OF LAND & WATER RESOURCES

JUN 25 1980


RECEIVED

(8) how well bottom plugged  
2" sand shark

DRILLERS REMARKS:  
15' tail pipe

If well telescopes please sketch and show depths.

GROUND LEVEL

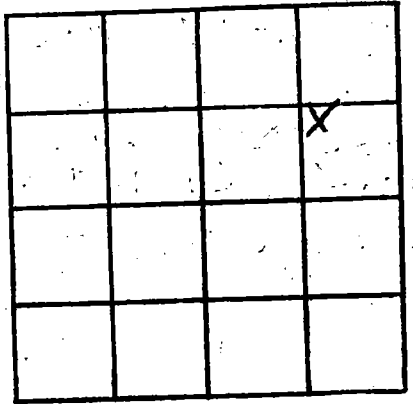

SECTION 36

Please indicate well location X.

ADDITIONAL INFORMATION

If more than one screen, show locations of each on sketch.