

HARRISON
 6329

MISSISSIPPI
 BOARD OF WATER COMMISSIONERS
 416 North State Street
 Jackson, Mississippi 39201

CODED

WATER WELL DRILLERS LOG

5/16/80 19 date well completed
 Lyman Well Co. firm name
 Harrison county well located

LANDOWNER: Dean Cowart
 South Swan Rd
 Gulfport, MS 39503
 (mailing address)

description of formations encountered	from	to
yellow clay	0	12
Blm clay	12	60
Sand and fine	60	170
gray clay Blm clay	170	420
Sand gravel	420	525
Blue shale	525	580
sand fine	580	640

WELL LOCATION:
 sec. 29 T. 6 N. R. 11 E.
 10 miles N of Gulfport
 (distance) (direction) (nearest town)

WELL PURPOSE: Home
 (home, irrigation, municipal, industrial)

WELL COMPLETION DATA:

- (1) diameter (inches) 2
- (2) total depth (feet) 640'
- (3) static water level (feet) 72' below top of ground
- (4) casing PVC 620'
 (material) (depth)
 2" If telescope see back.
 (size)
- (5) screen 20' 620'
 (length) (depth to top)
 2" 8 slot PVC
 (size) (material)
- (6) pump 1 1/2 10
 (HP) (yield gpm)
 electric
 (type power)
- (7) electric log No
 (yes or no)
 NO
 (organization running log)
- (8) how well bottom plugged Sand
 Shark

CODED

DRILLERS REMARKS:


DEPT. OF NATURAL RESOURCES
 BUREAU OF LAND & WATER RESOURCES

JUN 20 1980

RECEIVED

If well telescopes please sketch and show depths.

GROUND LEVEL

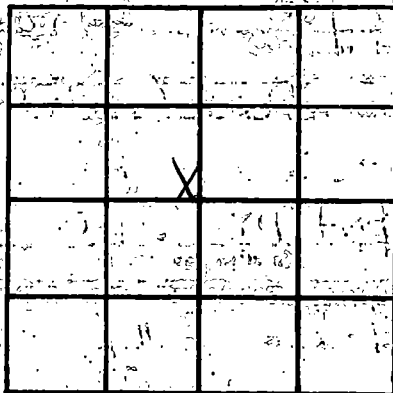

SECTION 29

Please indicate well location X.

ADDITIONAL INFORMATION

If more than one screen, show locations of each on sketch.