

MISSISSIPPI
BOARD OF WATER COMMISSIONERS

416 North State Street
Jackson, Mississippi 39201

CODED

WATER WELL DRILLERS LOG

G 331
6-11-80

10-11-1980 date well completed
SER. INC. Braden Pump Well firm name
HARRISON county well located

LANDOWNER:
RONALD SHAMBURGER
1810 West James Circle

Pass Christian, MISSISSIPPI
(mailing address)

WELL LOCATION:
sec. 29 T. 6 S. R. 11 W.
miles in of Lyman
(distance) (direction) (nearest town)

WELL PURPOSE: NURSERY
(home, irrigation, municipal, industrial)

WELL COMPLETION DATA:
(1) diameter (inches) 4"
(2) total depth (feet) 650'
(3) static water level (feet) 90' below top of ground.
(4) casing PVC, total! (material) (depth)
4" (size) If telescope see back.
(5) screen 20' (length) 630' (depth to top)
4" (size) PVC underbar (material)
(6) pump 1 1/2 (HP) 230 (yield gpm)
230 (type power)
(7) electric log no (yes or no)
(organization running log)
(8) how well bottom plugged
2" B.W. GAUGE

description of formations encountered	from to	
Clay	0	90
Sand	90	147
Clay	147	150
Sand + Clay	150	200
Clay	200	300
SAND	300	346
CLAY	346	400
SAND	400	548
Clay	548	550
SAND	550	650

CODED

DEPT. OF NATURAL RESOURCES
BUREAU OF LAND & WATER RESOURCES

JUL - 2 1980


RECEIVED

DRILLERS REMARKS:
NO TAIL PIPE

If well telescopes please sketch and show depths.

HARRISON

GROUND LEVEL

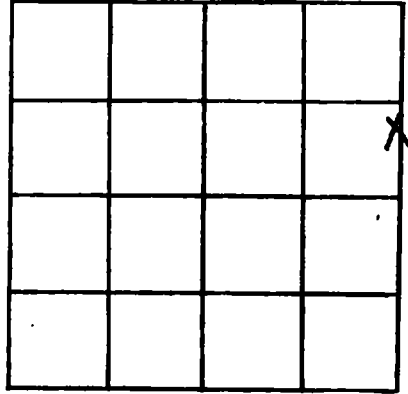

SECTION 29

Please indicate well location X.

ADDITIONAL INFORMATION

If more than one screen,
show locations of each on sketch.