

MISSISSIPPI DEPARTMENT OF NATURAL RESOURCES

Bureau of Land and Water Resources

Southport Mall

P.O. Box 10631

**CODED**

Jackson, Mississippi 39209

WATER WELL DRILLERS LOG

HARRISON  
G 339

11/80  
11/80  
date well completed

19 Lyman Well Co.  
firm name

Harrison  
county well located

LANDOWNER: Robert A Webb, Jr.  
Rt 2 Box 288 M  
Southport, Md 39503  
(mailing address)

description of formations encountered	from	to
<u>Red sand &amp; clay</u>	<u>0</u>	<u>7</u>
<u>Yellow &amp; white clay</u>	<u>7</u>	<u>25</u>
<u>Blue clay &amp; gray sand</u>	<u>25</u>	<u>160</u>
<u>SAND</u>	<u>160</u>	<u>230</u>

WELL LOCATION:  
sec. 30 T-5 N R-12 E  
11 miles (distance) SW (direction) of Southport (nearest town)

**CODED**

WELL PURPOSE: None  
(home, irrigation, municipal, industrial)

WELL COMPLETION DATA:

(1) diameter (inches) 2"

(2) total depth (feet) 230'

(3) static water level (feet) 43' below top of ground.

(4) casing POC (material), 220 (depth)

(size) If telescope see back.

(5) screen 10' (length), 220 (depth to top)

8 (size), POC (material)

(6) pump 1 (HP), 14 (yield gpm)

g/ac (type power)

(7) electric log No (yes or no)

(organization running log)

(8) how well bottom plugged part

DRILLERS REMARKS:


DEPT. OF NATURAL RESOURCES  
BUREAU OF LAND & WATER RESOURCES

FEB 19 1981

**RECEIVED**

If well telescopes please sketch and show depths.

GROUND LEVEL

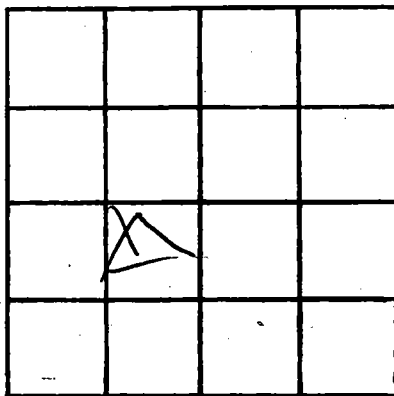

SECTION 11

Please indicate well location X.

ADDITIONAL INFORMATION

If more than one screen, show locations of each on sketch.