

MISSISSIPPI DEPARTMENT OF NATURAL RESOURCES

Bureau of Land and Water Resources

Southport Mall

P.O. Box 10631

Jackson, Mississippi 39209

WATER WELL DRILLERS LOG

CODED

HARRISON
G 340
1/30/81
1/30/81 19
 date well completed

Rayman Well Co. firm name
Harrison County county well located

LANDOWNER: The Allans
01570 Beach Dr
Gulfport, MS 39501
 (mailing address)

description of formations encountered	from	to
<u>yellow clay</u>	<u>0</u>	<u>8</u>
<u>loose sand & clay breaks</u>	<u>8</u>	<u>120</u>
<u>blue & gray clay-sand</u>	<u>120</u>	<u>310</u>
<u>SAND</u>	<u>310</u>	<u>372</u>

WELL LOCATION:
 sec 29 T 6 N R 11 E
11 miles (distance) W (direction) of Gulfport (nearest town)

WELL PURPOSE: home
 (home, irrigation, municipal, industrial)

WELL COMPLETION DATA:

(1) diameter (inches) 2 1/2

(2) total depth (feet) 372'

(3) static water level (feet) 59 below top of ground.

(4) casing PVC (material), 362 (depth)

(size) if telescope see back.

(5) screen 10' (length), 362 (depth to top)

6 slot (size), PVC (material)

(6) pump 1/2 (HP), 8 (yield gpm)

2/64 (type power)

(7) electric log NO (yes or no).

(organization running log)

(8) how well bottom plugged sealed

DRILLERS REMARKS:

CODED


DEPT. OF NATURAL RESOURCES
 BUREAU OF LAND & WATER RESOURCES

FEB 19 1981

RECEIVED

If well telescopes please sketch and show depths.

GROUND LEVEL

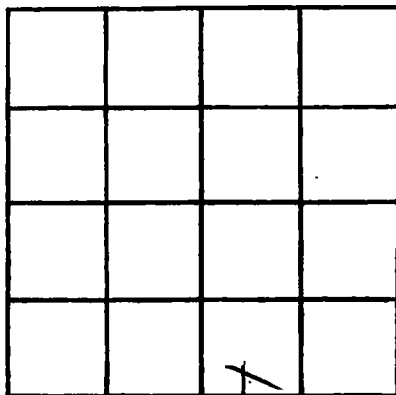

SECTION 20

Please indicate well location X.

ADDITIONAL INFORMATION

If more than one screen, show locations of each on sketch.