

MISSISSIPPI DEPARTMENT OF NATURAL RESOURCES

Bureau of Land and Water Resources

Southport Mall

P.O. Box 10631

Jackson, Mississippi 39209

WATER WELL DRILLERS LOG

CODED

HARRISON
5342
5/7/81
577-81

date well completed

firm name

county well located

Lyman Well Co

Harrison

LANDOWNER: Vernon Odum
Rt 11 Box 456
Gulfport, MS
(mailing address)


description of formations encountered	from	to
Red Clay	0	15
Sand (yr. flow type)	15	189
Blue & gray Clay	129	333
yellow sand	333	373
Blue clay	373	472
SAND	472	581

WELL LOCATION:
? sec. 9 T 8 N R 11 E
5 miles N of Gulfport
(distance) (direction) (nearest town)

WELL PURPOSE: Home
(home, irrigation, municipal, industrial)

- WELL COMPLETION DATA:
- (1) diameter (inches) 2"
 - (2) total depth (feet) 581'
 - (3) static water level (feet) 55 below above top of ground.
 - (4) casing PVC, 571'
(material) (depth)
2"
(size) If telescope see back.
 - (5) screen 10', 571'
(length) (depth to top)
2", PVC
(size) (material)
 - (6) pump 1 (HP) 10 (yield gpm)
electric
(type power)
 - (7) electric log NO (yes or no)
NO
(organization running log)
 - (8) how well bottom plugged sand
shark


CODED

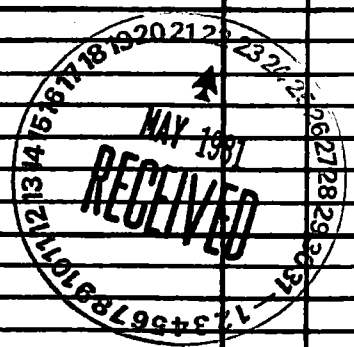

DRILLERS REMARKS:

If well telescopes please sketch and show depths.

GROUND LEVEL

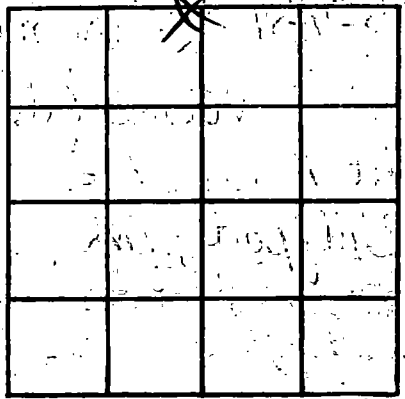

SECTION _____

Please indicate well location X.

ADDITIONAL INFORMATION

Multiple horizontal lines for additional information.

If more than one screen, show locations of each on sketch.