

MISSISSIPPI DEPARTMENT OF NATURAL RESOURCES

Bureau of Land and Water Resources

Southport Mall

P.O. Box 10631

Jackson, Mississippi 39209

WATER WELL DRILLERS LOG

CODED

HARRISON
 L 343
 5/11/81

5-11-81
 date well completed

19 Lyman Well Co.
 firm name

Harrison
 county well located

LANDOWNER: Thozark Landrum
Rt 3 Box 63
Gulfport 39503
 (mailing address)

description of formations encountered

from

to

Red clay 17 30
 yellow sand 30 123

Blue gray clay 123 258
 sand 258 272

Blue clay 272 454
 sand 454 516

WELL LOCATION:

sec 27 T 6 N R 11 E
2 miles E of LYMAN
 (distance) (direction) (nearest town)

WELL PURPOSE: Home
 (home, irrigation, municipal, industrial)

WELL COMPLETION DATA:

(1) diameter (inches) 2"
 (2) total depth (feet) 516'
 (3) static water level (feet) 65 below above top of ground.

(4) casing PVC, 506'
 (material) (depth)

2"
 (size) if telescope see back.

(5) screen 10', 506'
 (length) (depth to top)

2", PVC
 (size) (material)

(6) pump 1, 10
 (HP) (yield gpm)


electric
 (type power)

(7) electric log No
 (yes or no)

No.
 (organization running log)

(8) how well bottom plugged sand
shark

CODED

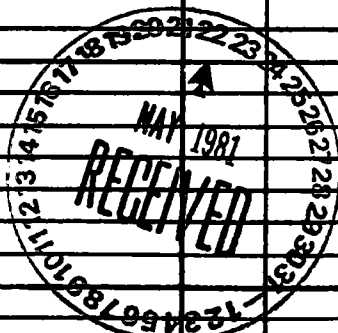

DRILLERS REMARKS:

