

MISSISSIPPI DEPARTMENT OF NATURAL RESOURCES

Bureau of Land and Water Resources

Southport Mall

P.O. Box 10631

Jackson, Mississippi 39209

WATER WELL DRILLERS LOG

CODED

HARRISON
5314
4/30/81
4/30/81

date well completed

firm name

county well located

19 Lyman Well Co

Harrison

LANDOWNER:

Johanna Dagnall
(Sea Coastal)

description of formations encountered

from

to

Hwy 49 North

Gulfport, Md 39503
(mailing address)

Red Clay 0 25
Yellow & Gray 25 80
Sand 80 150
Blue Clay & Sand 150 239

WELL LOCATION:

sec 28 T 6 N R 11 E
1/4 miles N of Gulfport
(distance) (direction) (nearest town)

Gray & white Clay 239 310
Sand (fine) 310 430

WELL PURPOSE:

drinking water
~~irrigation, municipal, industrial~~

430 509

WELL COMPLETION DATA:

(1) diameter (inches) 2"

(2) total depth (feet) 668'

(3) static water level (feet) 55 below above top of ground.

(4) casing PVC 658'
(material) (depth)
2"
(size) If telescope see back.


Blue Clay
fine sand 509 540
Blue Clay 540 568
CODED 568 668

(5) screen 10' 658'
(length) (depth to top)
2" PVC
(size) (material)

(6) pump 1/2 15
(HP) (yield gpm)
electric
(type power)

(7) electric log No
(yes or no)
No
(organization running log)

(8) how well bottom plugged sand
shark

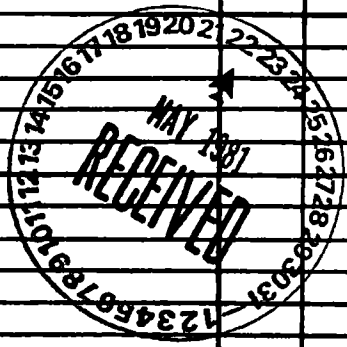

DRILLERS REMARKS:

If well telescopes please sketch and show depths.

GROUND LEVEL

SECTION _____

Please indicate well location X.

ADDITIONAL INFORMATION

If more than one screen, show locations of each on sketch.