

MISSISSIPPI DEPARTMENT OF NATURAL RESOURCES

Bureau of Land and Water Resources

Southport Mall

P.O. Box 10631

CODED

Jackson, Mississippi 39209

WATER WELL DRILLERS LOG

COASTAL DRILLING & SERVICE CO.

ROUTE 1 BOX 618

county well located

PILOXI, MISS. 39532

HARRISON
G 346
2-9-81

2/9/81 19
date well completed

LANDOWNER: Lenny Bradford
Quail Ridge
Alpha Club Apt. #101
(mailing address)

description of formations encountered

from

to

top soil	1	3
Red Clay	3	15
Orange white sand	15	45
Red Clay	45	60
Coarse white sand	60	210
Soft Blue Clay	210	325
Hard Blue Clay	325	505
fine water sand	505	525
Coarse water sand	525	560

WELL LOCATION:

sec. 31 T. 6 N. R. 11 W.
2 1/2 mi SW Jymon
(distance) miles (direction) of (nearest town)

WELL PURPOSE:

(home, irrigation, municipal, industrial) home

WELL COMPLETION DATA:

- (1) diameter (inches) 2"
- (2) total depth (feet) 560'
- (3) static water level (feet) 80' below above top of ground.
- (4) casing PVC 550'
(material) (depth)
- (size) if telescope see back.
- (5) screen 10' 550'
(length) (depth to top)
- 2"
(size) PVC
(material)
- (6) pump Oneill 12
(HP) (yield gpm)
- 5hp
(type power)
- (7) electric log No
(yes or no)

(organization running log)

(8) how well bottom plugged


DRILLERS REMARKS: 24 feet to water table
19-B

CODED



If well telescopes please sketch and show depths.

GROUND LEVEL

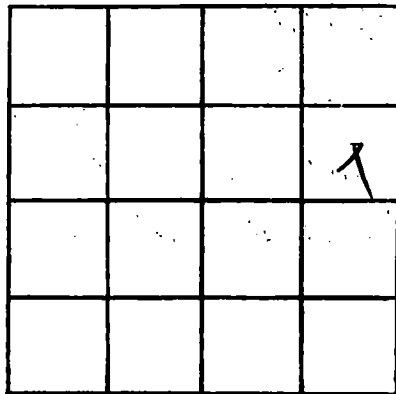

SECTION _____

Please indicate well location X.

ADDITIONAL INFORMATION

If more than one screen, show locations of each on sketch.