

MISSISSIPPI DEPARTMENT OF NATURAL RESOURCES

Bureau of Land and Water Resources

Southport Mall

P.O. Box 10631

CODED

Jackson, Mississippi 39209

WATER WELL DRILLERS LOG  
COASTAL DRILLING & SERVICE CO.

ROUTE 1 BOX 618

firm name

county well located

BILOXI, MISS. 39532

HARRISON  
6347  
3-23-81

3/23/81  
date well completed

LANDOWNER

description of formations encountered

from

to

*Frank Jelena*  
*Highway 53 Jeymon*  
*apt. 501's*  
(mailing address)

<i>top soil</i>	1	3
<i>Red Clay</i>	3	15
<i>Sandy Sand</i>	15	60
<i>Soft Blue Clay</i>	60	210
<i>fine water sand</i>	210	245
<i>Soft Blue Clay</i>	245	310
<i>hard blue clay</i>	310	410
<i>fine water sand</i>	410	425
<i>hard water sand</i>	425	460

WELL LOCATION:

sec. 19 T. 6 N. R. 12 E. S. 11 W.  
*(11 one NW) Jeymon*  
(distance) miles (direction) of (nearest town)

WELL PURPOSE:

(home, irrigation, municipal, industrial) *home*

WELL COMPLETION DATA:

- (1) diameter (inches) 2"
- (2) total depth (feet) 460'
- (3) static water level (feet) 600' below top of ground.
- (4) casing PVC, 450' (material), (depth)
- (size) if telescope see back.
- (5) screen 10', 450' (length), (depth to top)
- 2" (size), PVC (material)
- (6) pump one (HP), 11 (yield gpm)
- cle (type power)
- (7) electric log no (yes or no)


(organization running log)

(8) how well bottom plugged

2" Red Clay

DRILLERS REMARKS: 19-13

CODED

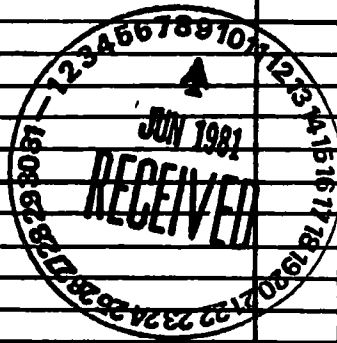

If well telescopes please sketch and show depths.

GROUND LEVEL

X			

SECTION \_\_\_\_\_

Please indicate well location X.

ADDITIONAL INFORMATION

If more than one screen, show locations of each on sketch.