

HARRISON  
G 348  
5-9-81

MISSISSIPPI  
BOARD OF WATER COMMISSIONERS  
416 North State Street  
Jackson, Mississippi 39201

CODED

WATER WELL DRILLERS LOG

5-9-81  
date well completed

BRADEN PUMP AND WELL SERVICE, INC. HARRISON  
firm name county well located

LANDOWNER:  
HARRY SCHERMER  
Rt 3, Box 265  
Mudfont MS  
(mailing address)

description of formations encountered	from	to
CLAY	0	20
SAND	20	40
CLAY	40	50
SAND	50	80
CLAY	80	170
SAND	170	180
CLAY	180	400
SAND	400	410
CLAY	410	420
SAND & clay	420	430
CLAY SAND	430	440
CLAY	440	455
SAND	455	460
CLAY	460	470
SAND	470	500

WELL LOCATION:  
sec. 32 T 6 N R 11 E  
1 miles S of Lyman  
(distance) (direction) (nearest town)

WELL PURPOSE: home  
(home, irrigation, municipal, industrial)

WELL COMPLETION DATA:

- (1) diameter (inches) 4 1/2
- (2) total depth (feet) 500
- (3) static water level (feet) 65 below top of ground.
- (4) casing PVC, total! (material), (depth)  
4 1/2 (size) If telescope see back.
- (5) screen 10 (length), 485 (depth to top)  
2" (size), PVC underbar (material)
- (6) pump 1 (HP), 18 (yield gpm)  
230 (type power)
- (7) electric log NO (yes or no)
- (organization running log)

CODED

(8) how well bottom plugged  
2" SAND SHARK

DRILLERS REMARKS:  
5' tail pipe


DEPT. OF NATURAL RESOURCES  
BUREAU OF LAND & WATER RESOURCES

JUN 2 - 1981

RECEIVED

If well telescopes please sketch and show depths.

GROUND LEVEL

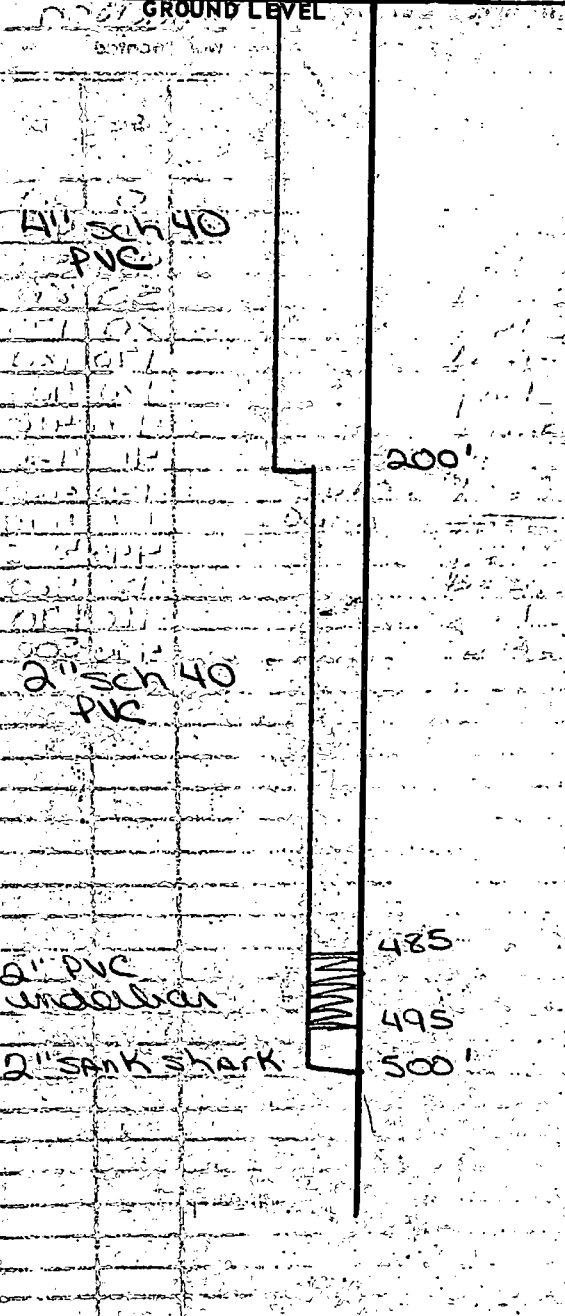

		X	

SECTION 32

Please indicate well location X

ADDITIONAL INFORMATION

Handwritten notes in the additional information section include:

- 200'
- 485'
- 495'
- 500'
- 2" SANK SHARK
- 1
- OFF

If more than one screen, show locations of each on sketch.