

MISSISSIPPI DEPARTMENT OF NATURAL RESOURCES

Bureau of Land and Water Resources

Southport Mall

P.O. Box 10631

Jackson, Mississippi 39209

WATER WELL DRILLERS LOG

COASTAL DRILLING & SERVICE CO.

ROUTE 1 in BOX 618

county well located

CODED

Harrison
G349
5-25-8

date well completed

5/25/81 19

Harrison

LANDOWNER

C. W. Hoff BILOXI, MISS. 39532

description of formations encountered

from

to

John Clark Road
Dept. Min
 (mailing address)

<u>top soil</u>	<u>1</u>	<u>3</u>
<u>Red Clay</u>	<u>3</u>	<u>18</u>
<u>Coarse white sand</u>	<u>18</u>	<u>60</u>
<u>gray sand</u>	<u>60</u>	<u>110</u>
<u>Soft Blue Clay</u>	<u>110</u>	<u>310</u>
<u>fine white sand</u>	<u>310</u>	<u>340</u>
<u>Soft blue clay</u>	<u>340</u>	<u>410</u>
<u>hard blue clay</u>	<u>410</u>	<u>515</u>
<u>fine white sand</u>	<u>515</u>	<u>525</u>
<u>gray white sand</u>	<u>525</u>	<u>565</u>

WELL LOCATION:

sec. 32 T. 6 N. R. 11 E.
S W
Flat Branch
 (distance) (direction) (nearest town)

WELL PURPOSE:

(home, irrigation, municipal, industrial) home

WELL COMPLETION DATA:

- (1) diameter (inches) 2"
- (2) total depth (feet) 565'
- (3) static water level (feet) 60' below above top of ground.
- (4) casing Al 555'
 (material) (depth)
 (size) If telescope see back.
- (5) screen 10' 555'
 (length) (depth to top)
2" Al
 (size) (material)
- (6) pump One 11
 (HP) (yield gpm)
3hp
 (type power)
- (7) electric log no
 (yes or no)
 (organization running log)

CODED

DEPT. OF NATURAL RESOURCES
 BUREAU OF LAND & WATER RESOURCES

JUL 22 1981

RECEIVED


(8) how well bottom plugged

2" hard blue clay
19-8

DRILLERS REMARKS:

If well telescopes please sketch and show depths.

GROUND LEVEL

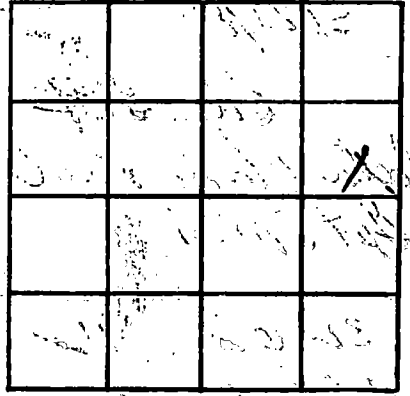

SECTION _____

Please indicate well location X.

ADDITIONAL INFORMATION

A series of horizontal lines for writing additional information, with some faint handwritten notes visible.

If more than one screen, show locations of each on sketch.