

Harrison  
 G 350  
 7-1-81

MISSISSIPPI  
 BOARD OF WATER COMMISSIONERS  
 416 North State Street  
 Jackson, Mississippi 39201

CODED

WATER WELL DRILLERS LOG  
 BRADEN PUMP AND WELL SERVICE, INC.

7-1-81  
 date well completed

ROUTE 1, BOX 489

HARRISON  
 county well located

SAUCIER, MS <sup>firm name</sup> 39574

LANDOWNER:  
 Con Federate Building Supply  
 P.O. Box 3201  
 Gulfport, MS 39503  
 (mailing address)


description of formations encountered	from to	
CLAY	0	15
SAND	15	80
CLAY	80	290
Sand	290	360

WELL LOCATION:  
 sec. 17 T6 N R11 E  
 1 miles N of LUMAN  
 (distance) (direction) (nearest town)

CODED

WELL PURPOSE: BUSINESS  
 (home, irrigation, municipal, industrial)

- WELL COMPLETION DATA:
- (1) diameter (inches) 4 1/2
  - (2) total depth (feet) 360'
  - (3) static water level (feet) 18' below top of ground.
  - (4) casing AC (material), total (depth)  
4 1/2 (size) if telescope see back.
  - (5) screen 10' (length), 350' (depth to top)  
2" (size), PVC underlain (material)
  - (6) pump 1 (HP), 20 (yield gpm)  
230 (type power)
  - (7) electric log no (yes or no)
- (organization running log)
- (8) how well bottom plugged  
2" SAND SHARK

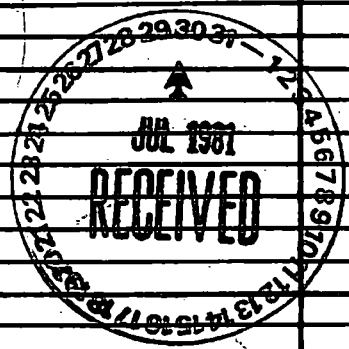

DRILLERS REMARKS:  
NO TAIL PIPE

If well telescopes please sketch and show depths.

GROUND LEVEL

4" sch 40  
PVC

4 1/2" PVC  
Bushing

2" sch 40  
PVC bushing

2" NO' PVC  
underbar  
screen

2" sand shark

160

350

360

			X

SECTION 17

Please indicate well location X.

ADDITIONAL INFORMATION

If more than one screen, show locations of each on sketch.