

well location 3 1/2 miles N Gulfport

HARRISON
G 351
7-10-81


MISSISSIPPI
BOARD OF WATER COMMISSIONERS
416 North State Street
Jackson, Mississippi 39201

CODED

WATER WELL DRILLERS LOG
BRADEN PUMP AND WELL SERVICE, INC. HARRISON

7-10-81 19-
date well completed ROUTE 1, BOX 489
SAUCIER, MS 39574
firm name county well located

LANDOWNER:	description of formations encountered	from	to
JOHN MASKEW Rt 5 Gulfport, MS 39503 (mailing address)			
WELL LOCATION:			
sec 36 T 6 N R 11 E S W	CODED		
3 1/2 miles N of Gulfport (distance) (direction) (nearest town)			
WELL PURPOSE: HOME (home, irrigation, municipal, industrial)			
WELL COMPLETION DATA:			
(1) diameter (inches) 2"			
(2) total depth (feet) 60			
(3) static water level (feet) 12 below top of ground			
(4) casing PVC, total (material) (depth) 2" if telescope see back.			
(5) screen 10 45 (length) (depth to top) 2" PVC underbar (size) (material)			
(6) pump pump not installed (HP) (yield gpm) 230 (type power)			
(7) electric log no (yes or no)			
(organization running log)			
(8) how well bottom plugged 2 1/2 SAND SHARK			
DRILLERS REMARKS: 5' tail pipe			

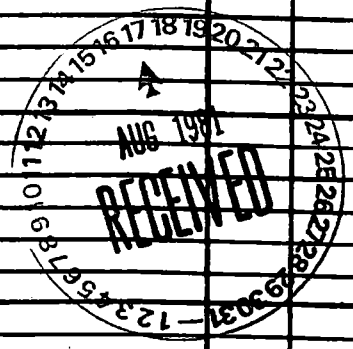

If well telescopes please sketch and show depths.

GROUND LEVEL

OP O
OR OP

4-1-1

		X	

SECTION 36

Please indicate well location X.

ADDITIONAL INFORMATION

001

34 01

If more than one screen, show locations of each on sketch.

04/1/11