

MISSISSIPPI DEPARTMENT OF NATURAL RESOURCES

Bureau of Land and Water Resources

Southport Mall

P.O. Box 10631

Jackson, Mississippi 39209

WATER WELL DRILLERS LOG

COASTAL DRILLING & SERVICE CO.

CODED

HARRISON
G 352
8-11-81

8/11/81
date well completed

ROUTE 1 BOX 618

Harrison
county well located

BILOXI, MISS. 39532

LANDOWNER *John Clark Reed*

description of formations encountered

from to

John Clark Reed
Flat min
(mailing address)

<i>Top Soil</i>	<i>1</i>	<i>3</i>
<i>Red Clay</i>	<i>3</i>	<i>18</i>
<i>Coarse white sand</i>	<i>18</i>	<i>70</i>
<i>Soft blue clay</i>	<i>70</i>	<i>110</i>
<i>Coarse white sand</i>	<i>180</i>	<i>240</i>
<i>Soft blue clay</i>	<i>240</i>	<i>320</i>
<i>hard blue clay</i>	<i>320</i>	<i>500</i>
<i>fine water sand</i>	<i>500</i>	<i>530</i>
<i>good water sand</i>	<i>550</i>	<i>585</i>

WELL LOCATION:


sec *31* T. *6* N R. *11* E
S W
Flat Branch
(distance) miles (direction) of (nearest town)

WELL PURPOSE: *home*
(home, irrigation, municipal, industrial)

WELL COMPLETION DATA:

- (1) diameter (inches) *4 1/2"*
- (2) total depth (feet) *585'*
- (3) static water level (feet) *75'* below above top of ground.
- (4) casing *PVC*, *570'*
(material), (depth)
4 1/2"
(size) If telescope see back.
- (5) screen *15'*, *570'*
(length), (depth to top)
2"
(size), *PVC*
(material)
- (6) pump *Oneill*, *15*
(HP), (yield gpm)
3hp
(type power)
- (7) electric log *no*
(yes or no)

CODED

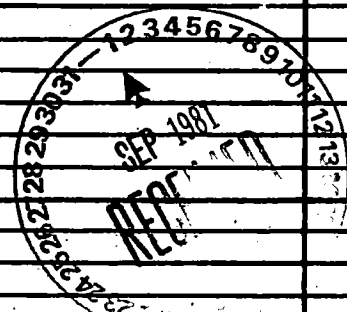

(organization running log)

(8) how well bottom plugged
2" inch value

DRILLERS REMARKS: *19-B*

If well telescopes please sketch and show depths.


GROUND LEVEL

206 4" PVC Casing

376 2" PVC Casing

15' 2" PVC Screen

2' backwash valve
19-B

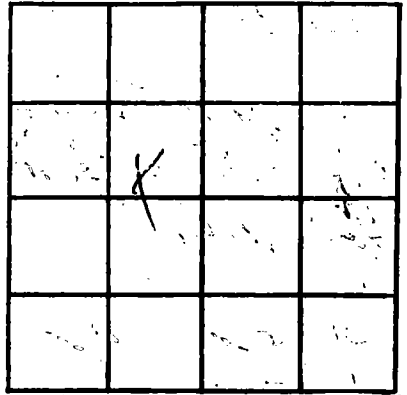

SECTION _____

Please indicate well location X.

ADDITIONAL INFORMATION

If more than one screen, show locations of each on sketch.