

MISSISSIPPI DEPARTMENT OF NATURAL RESOURCES

Bureau of Land and Water Resources

Southport Mall

P.O. Box 10631

Jackson, Mississippi 39209

WATER WELL DRILLERS LOG

CODED

HARRISON
G 354
5-17-81

5-17-81 19 Lyman Well Co. Harrison
 date well completed firm name county well located

LANDOWNER: Patrick Carson

description of formations encountered

from to

Old Hwy 49
Lpt, Tr 39503
 (mailing address)

Red Clay sand 0 40
Blue clay 40 115
good sand 115 150

WELL LOCATION:

sec. 18 T. 6 N. R. 11 E.
 (S) (W)
1/2 miles N/W of Lyman
 (distance) (direction) (nearest town)

WELL PURPOSE: home
 (home, irrigation, municipal, industrial)

WELL COMPLETION DATA:

- (1) diameter (inches) 5 2"
- (2) total depth (feet) 150'
- (3) static water level (feet) 60' below above top of ground.
- (4) casing PVC 140'
 (material) (depth)
2"
 (size) if telescope see back.
- (5) screen 10' 140'
 (length) (depth to top)
2" PVC
 (size) (material)
- (6) pump 1 12
 (HP) (yield gpm)
electric
 (type power)
- (7) electric log No
 (yes or no)
No
 (organization running log)
- (8) how well bottom plugged sand
shark

DRILLERS REMARKS:

CODED


DEPT. OF NATURAL RESOURCES
 BUREAU OF LAND & WATER RESOURCES

OCT 20 1981

RECEIVED

If well telescopes please sketch and show depths.

GROUND LEVEL

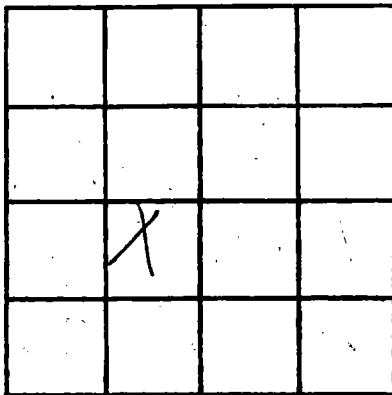

SECTION 18

Please indicate well location X.

ADDITIONAL INFORMATION

If more than one screen,
show locations of each on sketch.