

MISSISSIPPI DEPARTMENT OF NATURAL RESOURCES

Bureau of Land and Water Resources

Southport Mall

P.O. Box 10631

Jackson, Mississippi 39209

WATER WELL DRILLERS LOG

CODED

HARRISON
G 356
6-11-81

6-11-81
 date well completed

Lyman Well Co.
 firm name

Harrison
 county well located

LANDOWNER: Mc Morris
Quackworth Rd
Gulfport, MS 39503
 (mailing address)

description of formations encountered	from	to
yellow clay	0	7
red clay	7	18
sand & gravel	18	44
chry. blue	44	390
sand fin	390	460
blue clay	460	580
sand fan	580	674

WELL LOCATION:
 sec. 33 T 6 N R 11 E
8 miles N of Gulfport
 (distance) (direction) (nearest town)

WELL PURPOSE: Home
 (home, irrigation, municipal, industrial)

WELL COMPLETION DATA:

- (1) diameter (inches) 4x2
- (2) total depth (feet) 674
- (3) static water level (feet) 63 below above top of ground.
- (4) casing PVC 659'
 (material) (depth)
4x2 If telescope see back.
 (size)
- (5) screen 15' 659'
 (length) (depth to top)
2" PVC
 (size) (material)
- (6) pump 1 1
 (HP) (yield gpm)
electric
 (type power)
- (7) electric log NO
 (yes or no)
NO
 (organization running log)
- (8) how well bottom plugged sand
shark

CODED


DEPT. OF NATURAL RESOURCES
 BUREAU OF LAND & WATER RESOURCES

DEC 20 1981

RECEIVED

DRILLERS REMARKS:

If well telescopes please sketch and show depths.

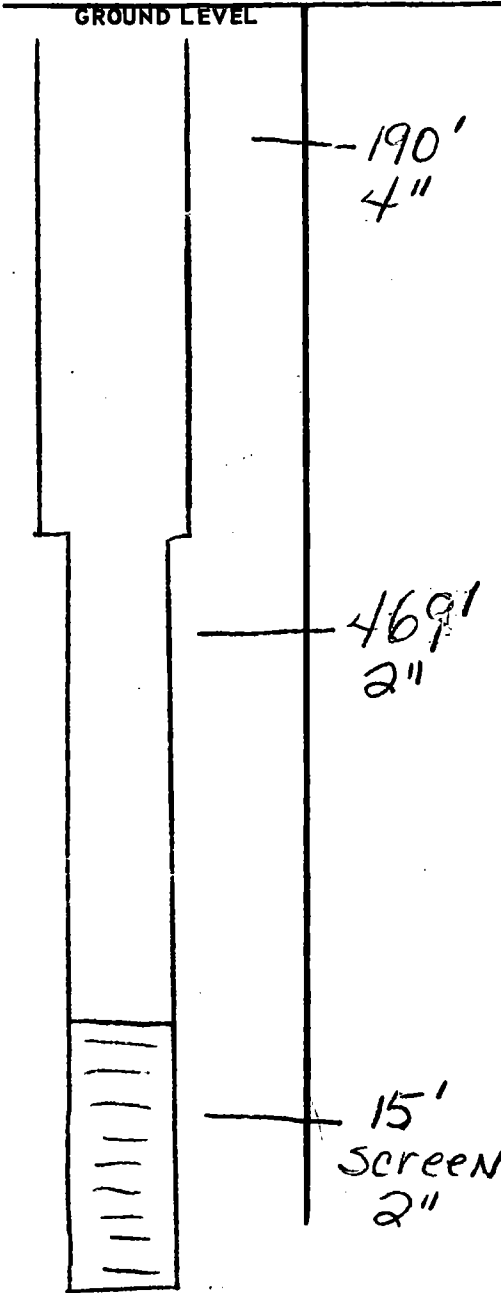

		X	

SECTION 33

Please indicate well location X.

ADDITIONAL INFORMATION

If more than one screen, show locations of each on sketch.