

MISSISSIPPI DEPARTMENT OF NATURAL RESOURCES

Bureau of Land and Water Resources

Southport Mall

P.O. Box 10631

Jackson, Mississippi 39209

WATER WELL DRILLERS LOG

31

CODED

HARRISON
G 357
7-2-81

7/2/81 date well completed 19 Syman Well Co. firm name Harrison county well located

LANDOWNER: Edwin Manor
Rt 3 Box 140
Gulfport, Ms 39503
(mailing address)

description of formations encountered	from	to
Red Clay	0	50
Gray Blue Clay	50	110
fine sand	110	138
Blue Clay	138	194
good sand	194	248'

WELL LOCATION:
sec. 29 T. 6 N. R. 11 E.
9 miles N of Gulfport
(distance) (direction) (nearest town)

WELL PURPOSE: home
(home, irrigation, municipal, industrial)

WELL COMPLETION DATA:

- (1) diameter (inches) 2"
- (2) total depth (feet) 248'
- (3) static water level (feet) 56 ^{below} ~~above~~ top of ground.
- (4) casing PVC 238'
(material) (depth)
- 2"
(size) if telescope see back.
- (5) screen 10' 238'
(length) (depth to top)
- 2" PVC
(size) (material)
- (6) pump 1 12
(HP) (yield gpm)
- electric
(type power)
- (7) electric log No
(yes or no)
- No
(organization running log)

(8) how well bottom plugged sand shark

DRILLERS REMARKS:

CODED


DEPT. OF NATURAL RESOURCES
BUREAU OF LAND & WATER RESOURCES

OCT 20 1981

RECEIVED

If well telescopes please sketch and show depths.

GROUND LEVEL

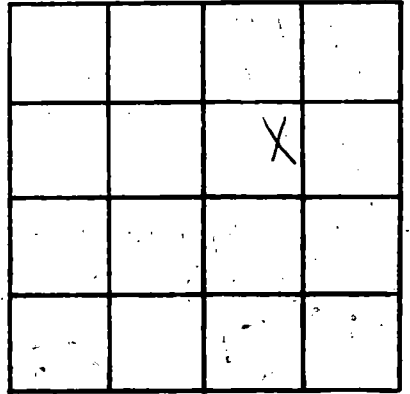

SECTION 29

Please indicate well location X.

ADDITIONAL INFORMATION

If more than one screen, show locations of each on sketch.