

MISSISSIPPI DEPARTMENT OF NATURAL RESOURCES

Bureau of Land and Water Resources

Southport Mall

P.O. Box 10631

Jackson, Mississippi 39209

WATER WELL DRILLERS LOG

CODED

HARRISON

G 358

7-16-81

date well completed

firm name

county well located

LANDOWNER

Description of formations encountered

from

to

Gaines Campbell
Rt 1 Box 517

Yellow clay
red sand & gravel
blue clay
sand & silt

0
7
50
40
480
480

Laurens, MS 39574
(mailing address)

WELL LOCATION:

sec. 5 T. 6 N. R. 11 E.
15 miles N of Southport
(distance) (direction) (nearest town)

WELL PURPOSE: Drone
(home, irrigation, municipal, industrial)

WELL COMPLETION DATA:

- (1) diameter (inches) 4x2
- (2) total depth (feet) 480
- (3) static water level (feet) 71 below above
top of ground.
- (4) casing PVC 465
(material) (depth)
4x2 If telescope see back.
(size)
- (5) screen 15' 465'
(length) (depth to top)
2" PVC
(size) (material)
- (6) pump 1 25
(HP) (yield gpm)
electric
(type power)
- (7) electric log No
(yes or no)
No
(organization running log)
- (8) how well bottom plugged sand
shark

DRILLERS REMARKS:

CODED

RECEIVED
OCT 20 1981

DEPT. OF NATURAL RESOURCES
BUREAU OF LAND & WATER RESOURCES

RECEIVED


If well telescopes please
sketch and show depths.

GROUND LEVEL

200'
4"
PVC

265'
2" PVC

15' 2"
screen

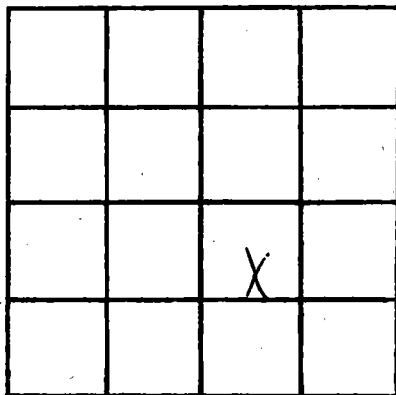

SECTION 5

Please indicate well location X.

ADDITIONAL INFORMATION

If more than one screen,
show locations of each on sketch.