

MISSISSIPPI DEPARTMENT OF NATURAL RESOURCES

Bureau of Land and Water Resources

Southport Mall

P.O. Box 10631

Jackson, Mississippi 39209

WATER WELL DRILLERS LOG

CODED

HARRISON
G 360
8-26-81

8-26-81, 19
date well completed

Lyman Well Co.
firm name

Harrison
county well located

LANDOWNER: Henry Wilson
Rt 3, Box 76
Gulfport, Md 39503
(mailing address)

description of formations encountered

from to

Red white Clay	0	60
Gray Clay	60	180
Light Sand	180	223
Blue Clay	223	400
Good Sand	400	503

WELL LOCATION:

sec. 27 T-6 N R-11 E
8 miles N of Gulfport
(distance) (direction) (nearest town)

WELL PURPOSE: Home
(home, irrigation, municipal, industrial)

WELL COMPLETION DATA:

- (1) diameter (inches) 2"
- (2) total depth (feet) 513
- (3) static water level (feet) 60' below top of ground.
- (4) casing PVC, 503' (material) (depth)
2" (size) if telescope see back.
- (5) screen 10', 503' (length) (depth to top)
2" (size) PVC (material)
- (6) pump 1 (HP) 12 (yield gpm)
electric (type power)
- (7) electric log No (yes or no)
No (organization running log)
- (8) how well bottom plugged sand seal

CODED

DEPT. OF NATURAL RESOURCES
BUREAU OF LAND & WATER RESOURCES


OCT 20 1981

RECEIVED

DRILLERS REMARKS:

If well telescopes please sketch and show depths.

GROUND LEVEL

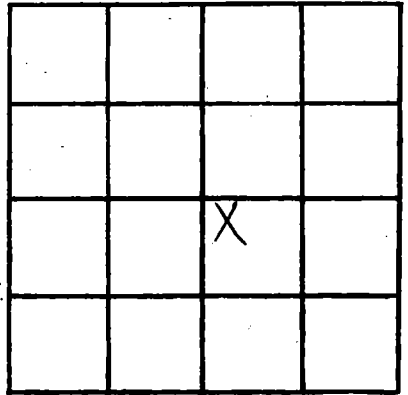

SECTION 27

Please indicate well location X.

ADDITIONAL INFORMATION

A series of horizontal lines for writing additional information.

If more than one screen, show locations of each on sketch.