

MISSISSIPPI DEPARTMENT OF NATURAL RESOURCES

Bureau of Land and Water Resources

Southport Mall

P.O. Box 10631

Jackson, Mississippi 39209

WATER WELL DRILLERS LOG

CODED

HARRISON
G 361
6-2-81

6-2-81
date well completed

Lyman Well Co.
firm name

Harrison
county well located

LANDOWNER: Donald Pannell
Lumpkin Rd
Gulfport, Ms 39503
(mailing address)

description of formations encountered	from	to
<u>Red Clay & white sand</u>	<u>0</u>	<u>100</u>
<u>Gray Clay</u>	<u>100</u>	<u>240</u>
<u>fine sand in clay</u>	<u>240</u>	<u>340</u>
<u>Blue Clay</u>	<u>340</u>	<u>400</u>
<u>good sand</u>	<u>400</u>	<u>478</u>

WELL LOCATION:
sec. 30 T-6 N R-11 E
10 miles N of Gulfport
(distance) (direction) (nearest town)

WELL PURPOSE: home
(home, irrigation, municipal, industrial)

- WELL COMPLETION DATA:
- (1) diameter (inches) 4x2
 - (2) total depth (feet) 478
 - (3) static water level (feet) 53 below above top of ground.
 - (4) casing PVC 458'
(material) (depth)
 - 4x2 If telescope see back.
(size)
 - (5) screen 20' 458'
(length) (depth to top)
 - 2" PVC
(size) (material)
 - (6) pump 1 25
(HP) (yield gpm)
 - electric
(type power)
 - (7) electric log NO
(yes or no)
 - NO
(organization running log)
 - (8) how well bottom plugged sand shark

CODED



DEPT. OF NATURAL RESOURCES
BUREAU OF LAND & WATER RESOURCES

DEC 20 1981

RECEIVED

DRILLERS REMARKS:

If well telescopes please sketch and show depths.

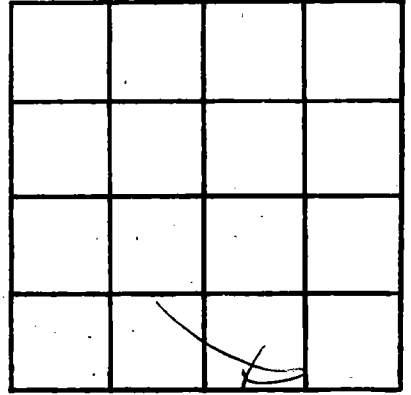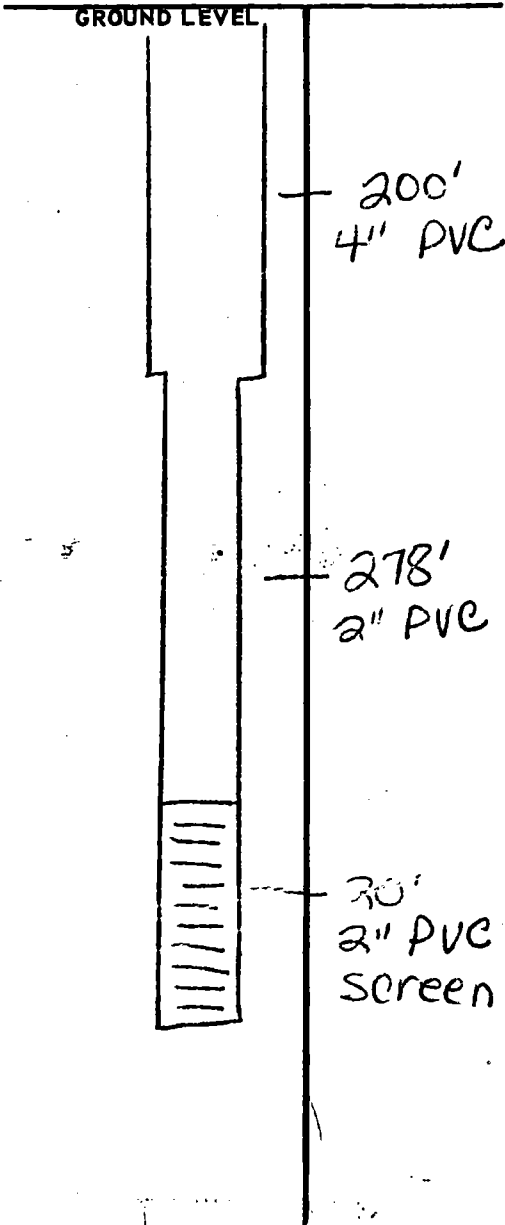

SECTION 30

Please indicate well location X.

ADDITIONAL INFORMATION

If more than one screen,
show locations of each on sketch.