

MISSISSIPPI DEPARTMENT OF NATURAL RESOURCES

Bureau of Land and Water Resources

Southport Mall

P.O. Box 10631

Jackson, Mississippi 39209

COASTAL WATERWELL DRILLERS LOG

ROUTE 1 BOX 618

BILOXI, MISS. 39532

CODED

Harrison  
G-363

12/18/81  
date/well completed

Harrison  
county well located

LANDOWNER: James Jackson  
South Sun Road  
apt 111  
(mailing address)

description of formations encountered	from	to
Top Soil	1	3
Red Clay	3	18
Coarse white sand	18	60
Soft Blue Clay	60	170
Slip Sand	170	190
Coarse white sand	190	230
Soft Blue Clay	230	310
Hard Blue Clay	310	490
fine water sand	490	530
good water sand	530	550

WELL LOCATION:  
sec 27 T 6 N R 11 E  
S W  
1 1/2 miles NE Lynon  
(distance) (direction) (nearest town)

WELL PURPOSE: home  
(home, irrigation, municipal, industrial)

WELL COMPLETION DATA:

(1) diameter (inches) 4 1/2"

(2) total depth (feet) 550'

(3) static water level (feet) 78' below top of ground.

(4) casing PVC 535'  
(material) (depth)

4 1/2"  
(size) if telescope see back.

(5) screen 15' 535'  
(length) (depth to top)

2" PVC  
(size) (material)

(6) pump 1 1/2 28 gpm  
(HP) (yield gpm)

ele  
(type power)

(7) electric log no  
(yes or no)

(organization running log)

CODED

DEPT. OF NATURAL RESOURCES  
BUREAU OF LAND & WATER RESOURCES

JAN 15 1982


RECEIVED

(8) how well bottom plugged  
2" bed with valve  
DRILLERS REMARKS:  
successful well

If well telescopes please sketch and show depths.

GROUND LEVEL

200' 4" PVC Casing

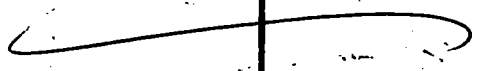


335' 2" PVC Casing

15' 2" PK Screen

2" lock wash valve

If more than one screen, show locations of each on sketch.

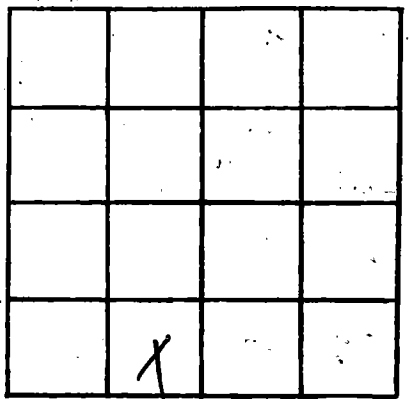

SECTION \_\_\_\_\_

Please indicate well location X.

ADDITIONAL INFORMATION

Multiple horizontal lines provided for additional information.