

MISSISSIPPI DEPARTMENT OF NATURAL RESOURCES

Bureau of Land and Water Resources

Southport Mall

P.O. Box 10631

Jackson, Mississippi 39209

CODED

WATER WELL DRILLERS LOG
COASTAL DRILLING & SERVICE CO.

ROUTE 1 BOX 618

Firm Name

county well located

BILOXI, MISS. 39532

Hannover

6364

1/28/81
date well completed

LANDOWNER: *Beard Home*
South-Sum Rd
4pt Min
(mailing address)

| description of formations encountered | from | to |
|---------------------------------------|------------|------------|
| <i>top soil</i> | <i>1</i> | <i>3</i> |
| <i>Red Clay</i> | <i>3</i> | <i>18</i> |
| <i>Sand-3rd</i> | <i>18</i> | <i>60</i> |
| <i>Soft Blue Clay</i> | <i>60</i> | <i>160</i> |
| <i>Coarse white Sand</i> | <i>160</i> | <i>225</i> |
| <i>Soft Blue Clay</i> | <i>225</i> | <i>290</i> |
| <i>Hard Blue Clay</i> | <i>290</i> | <i>460</i> |
| <i>fine water sand</i> | <i>460</i> | <i>475</i> |
| <i>good water sand</i> | <i>475</i> | <i>483</i> |
| <i>fine water sand</i> | <i>483</i> | <i>525</i> |
| <i>good water sand</i> | <i>525</i> | <i>560</i> |

WELL LOCATION:

sec 27 T 6 R 11 E
1 1/2 East Hannover
(distance) miles (direction) of (nearest town)

WELL PURPOSE:

(home, irrigation, municipal, industrial) *home*

WELL COMPLETION DATA:

- (1) diameter (inches) 4 1/2"
- (2) total depth (feet) 560'
- (3) static water level (feet) 60 below top of ground.
- (4) casing PVC 545'
(material) (depth)
4 1/2" If telescope see back.
(size)
- (5) screen 15' 545'
(length) (depth to top)
2" PVC
(size) (material)
- (6) pump 2HP 30 gpm
(HP) (yield gpm)
3/4"
(type power)
- (7) electric log no
(yes or no)

(organization running log)

(8) has well bottom plugged

2" back wash valve
DRILLERS REMARKS: Sand Seal

CODED

DEPT. OF NATURAL RESOURCES
BUREAU OF LAND & WATER RESOURCES

JAN 18 1982

RECEIVED

If well telescopes please sketch and show depths.


GROUND LEVEL

180'-4" PK Casing

365'-2" PK Casing

15'-2" PK Screen

7" backwash Valve Sand Seal

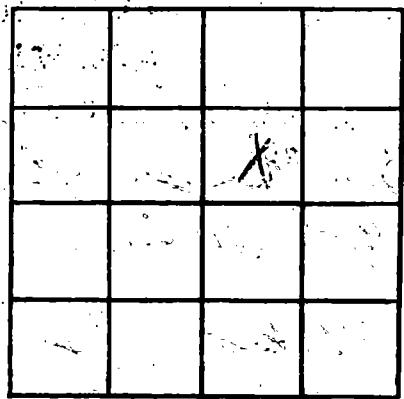

SECTION _____

Please indicate well location X.

ADDITIONAL INFORMATION

If more than one screen, show locations of each on sketch.