

MISSISSIPPI DEPARTMENT OF NATURAL RESOURCES

Bureau of Land and Water Resources

Southport Mall

P.O. Box 10631

Jackson, Mississippi 39209

**CODED**

COASTAL DRILLING & SERVICE CO. WATER WELL DRILLERS LOG

ROUTE 1 BOX 618

*Harrison*

7/19/81 date well completed

19 BILOXI, MISS firm name

county well located

LANDOWNER: *Tommy Bradford*

description of formations encountered

from to

*South Sun Road*

<i>top soil</i>	1	3
<i>red clay</i>	3	20
<i>super soil</i>	20	65
<i>soft blue clay</i>	65	175
<i>coarse white sand</i>	175	230
<i>soft blue clay</i>	230	300
<i>hard blue clay</i>	300	460
<i>fine water sand</i>	460	480
<i>coarse water sand</i>	480	490
<i>fine water sand</i>	490	520
<i>good water sand</i>	520	545

*Hpt man*  
(mailing address)

WELL LOCATION:

sec 27 T 6N R 11E  
*1/2 East Jena*  
(distance) miles (direction) (nearest town)

WELL PURPOSE: *home*  
(home, irrigation, municipal, industrial)

WELL COMPLETION DATA:

- (1) diameter (inches) 4 1/2"
- (2) total depth (feet) 545
- (3) static water level (feet) 45' below top of ground.
- (4) casing PVC (material), 530' (depth)  
4 1/2" (size) if telescope see back.
- (5) screen 15' (length), 530' (depth to top)  
2" (size), PVC (material)
- (6) pump 2 HP (HP), 35 gpm (yield gpm)  
cle (type power)
- (7) electric log no (yes or no)

**CODED**

DEPT. OF NATURAL RESOURCES  
BUREAU OF LAND & WATER RESOURCES

JAN 18 1982

**RECEIVED**

(8) how well bottom plugged 2 feet with valve  
DRILLERS REMARKS: Sand Seal

If well telescopes please sketch and show depths.


GROUND LEVEL

180'-4" PVC Casing

350'-2" PVC Casing

15'-2" Screen  
PVC

2" back wash Valve  
Sand Seal

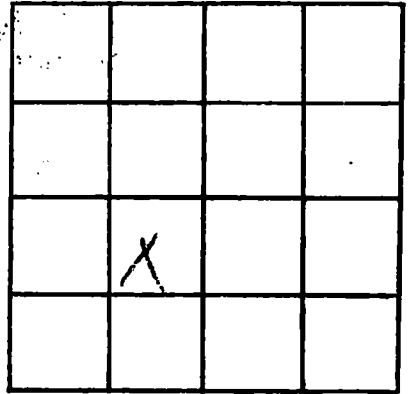

SECTION \_\_\_\_\_

Please indicate well location X.

ADDITIONAL INFORMATION

If more than one screen,  
show locations of each on sketch.