

MISSISSIPPI DEPARTMENT OF NATURAL RESOURCES
Bureau of Land and Water Resources
 Southport Mall
 P.O. Box 10631
 Jackson, Mississippi 39209
WATER WELL DRILLERS LOG

CODED

Harrison
G-367

12/11/81 19 Syman Well Co. Harrison
 date well completed firm name county well located

LANDOWNER: Cecil Page
Rt. 1, Box 360
Saucier, Md
 (mailing address)

description of formations encountered	from	to
Red Soil	0	60
Gravel Clay	60	100
Blue Clay	100	160
Good Sand	160	189

WELL LOCATION:
 sec. 5 T. 6 N. R. 11 E
6 miles (distance) S (direction) of Saucier (nearest town)

CODED

WELL PURPOSE: Home
 (home, irrigation, municipal, industrial)

- WELL COMPLETION DATA:**
- (1) diameter (inches) 2"
 - (2) total depth (feet) 189'
 - (3) static water level (feet) 10 below top of ground.
 - (4) casing PVC 179'
 (material) (depth)
2" if telescope see back.
 (size)
 - (5) screen 10' 179'
 (length) (depth to top)
2" PVC
 (size) (material)
 - (6) pump NA NA
 (HP) (yield gpm)
NA
 (type power)
 - (7) electric log NO
 (yes or no)
NO
 (organization running log)
 - (8) how well bottom plugged sand
shark

MISSISSIPPI DEPARTMENT OF NATURAL RESOURCES
 BUREAU OF LAND AND WATER RESOURCES


APR 25 1982

RECEIVED

DRILLERS REMARKS:

If well telescopes please sketch and show depths.

GROUND LEVEL

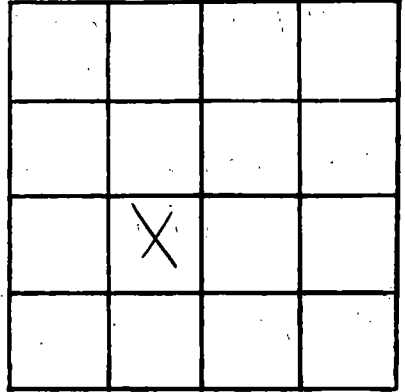

SECTION 5

Please indicate well location X.

ADDITIONAL INFORMATION

If more than one screen, show locations of each on sketch.