

MISSISSIPPI DEPARTMENT OF NATURAL RESOURCES
Bureau of Land and Water Resources
 Southport Mall
 P.O. Box 10631
 Jackson, Mississippi 39209
WATER WELL DRILLERS LOG

CODED

Harrison
6370

2/15 1982 Lyman Well Co. Harrison
 date well completed firm name county well located

LANDOWNER: Switzer
Three Rivers Estates
Cpt. Ms.
 (mailing address)

description of formations encountered	from	to
<u>Red Sand & gravel</u>	<u>0</u>	<u>60</u>
<u>Clay</u>		
<u>White & Gray Clay</u>	<u>60</u>	<u>140</u>
<u>Blue Clay</u>	<u>140</u>	<u>270</u>
<u>Fair Sand</u>	<u>270</u>	<u>320</u>
<u>Sand & Clay Mixed</u>	<u>320</u>	<u>400</u>
<u>Fair Sand</u>	<u>400</u>	<u>440</u>
<u>Good Sand</u>	<u>440</u>	<u>490</u>

WELL LOCATION:
 sec. 6 T. 6 N. R. 11 E. Group
4 miles NW of Orange
 (distance) (direction) (nearest town)

WELL PURPOSE: Home
 (home, irrigation, municipal, industrial)

WELL COMPLETION DATA:

(1) diameter (inches) 4x2

(2) total depth (feet) 490

(3) static water level (feet) 50' below top of ground.

(4) casing PVC 490
 (material) (depth)

4x2 If telescope see back.
 (size)

(5) screen 20' 490
 (length) (depth to top)

2" PVC
 (size) (material)

(6) pump 1 20
 (HP) (yield gpm)

Elect.
 (type power)

(7) electric log NO
 (yes or no)

NO
 (organization running log) Sand Shark

(8) how well bottom plugged


CODED

DRILLERS REMARKS:

MISSISSIPPI DEPARTMENT OF NATURAL RESOURCES
 Bureau of Land and Water Resources
 APR 25 1982

If well telescopes please sketch and show depths.

GROUND LEVEL

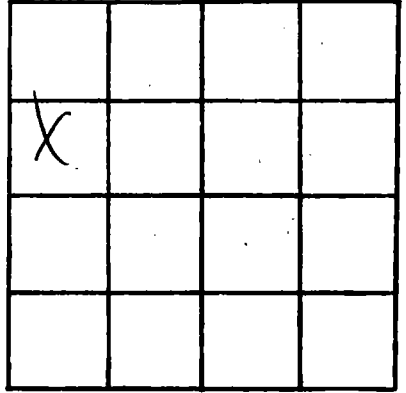

SECTION 28

Please indicate well location X.

ADDITIONAL INFORMATION

If more than one screen, show locations of each on sketch.