

MISSISSIPPI DEPARTMENT OF NATURAL RESOURCES

Bureau of Land and Water Resources

Southport Mall

P.O. Box 10631

Jackson, Mississippi 39209

WATER WELL DRILLERS LOG

CODED

Harrison
G372

4/28/82 19
date well completed

Rayman Well Co.
firm name

Harrison Cnty.
county well located

LANDOWNER: First Free Church of God

Rt. 2, Box 60
Saucier (mailing address) 39574

WELL LOCATION:
sec. 26 T. 6 N. R. 11 E.
3 miles (distance) SE (direction) of Rayman (nearest town)

WELL PURPOSE: Church
(home, irrigation, municipal, industrial)

WELL COMPLETION DATA:

- (1) diameter (inches) 2"
- (2) total depth (feet) 516'
- (3) static water level (feet) 30 below above top of ground.
- (4) casing 2 PVC, 516' (material) (depth)
2" (size) if telescope see back.
- (5) screen 10', 506' (length) (depth to top)
2" (size), PVC (material)
- (6) pump 1 (HP) 15 (yield gpm)
Elect (type power)
- (7) electric log N/A (yes or no)
N/A (organization running log)
- (8) how well bottom plugged Sand Shark

description of formations encountered	from	to
Red Sand & Clay	0	100
Blue Clay	100	150
Fine Sand & Clay	150	278
Fair Sand	278	343
Blue Clay	343	408
Medium Sand	408	516

CODED

DRILLERS REMARKS:


DEPT. OF NATURAL RESOURCES
BUREAU OF LAND & WATER RESOURCES

JUL 20 1982

RECEIVED

If well telescopes please sketch and show depths.

GROUND LEVEL

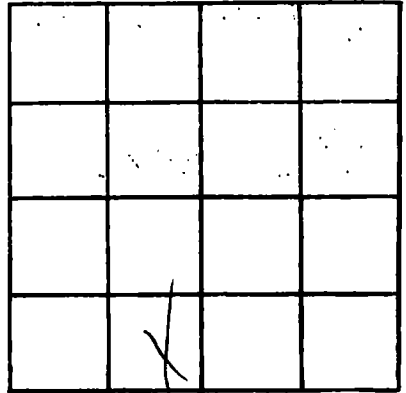

SECTION 26

Please indicate well location X.

ADDITIONAL INFORMATION

If more than one screen, show locations of each on sketch.