

MISSISSIPPI DEPARTMENT OF NATURAL RESOURCES

Bureau of Land and Water Resources

Southport Mall

P.O. Box 10631

Jackson, Mississippi 39209

WATER WELL DRILLERS LOG

CODED

Harrison
G374

6/2 1982 Sa Lynon Well Co. Harrison City
date well completed firm name county well located

LANDOWNER: John Dobson
Rt. 3, Box 123C
Southport, Ms 39503
(mailing address)

description of formations encountered	from	to
<u>Red Sand & Clay</u>	<u>0</u>	<u>80</u>
<u>Gumbo Clay</u>	<u>80</u>	<u>140</u>
<u>Fine Sand & Clay</u>	<u>140</u>	<u>200</u>
<u>Blue Clay</u>	<u>200</u>	<u>360</u>
<u>Blue Clay & Fine Sand</u>	<u>360</u>	<u>430</u>
<u>Good Sand</u>	<u>430</u>	<u>461</u>

WELL LOCATION:
sec. 15 T. 6 N. R. 11 E.
1 miles NE of Rayman
(distance) (direction) (nearest town)

WELL PURPOSE: Home
(home, irrigation, municipal, industrial)

WELL COMPLETION DATA:

- (1) diameter (inches) 2"
- (2) total depth (feet) 461
- (3) static water level (feet) 60 below top of ground.
- (4) casing PVC, 451,
(material) (depth)
2"
(size) if telescope see back.
- (5) screen 10', 461
(length) (depth to top)
2", PVC
(size) (material)
- (6) pump 1, 12
(HP) (yield gpm)
Elec.
(type power)
- (7) electric log NO
(yes or no)
NO
(organization running log) Sand Shark
- (8) how well bottom plugged Shark

CODED

DEPT. OF NATURAL RESOURCES
BUREAU OF LAND & WATER RESOURCES


JUL 14 1982

RECEIVED

DRILLERS REMARKS:

If well telescopes please sketch and show depths.

GROUND LEVEL.

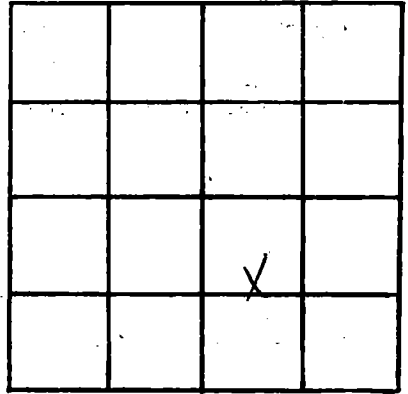

SECTION 15

Please indicate well location X.

ADDITIONAL INFORMATION

If more than one screen, show locations of each on sketch.