

HARRISON
G 376
10-2-80

MISSISSIPPI
 BOARD OF WATER COMMISSIONERS
 416 North State Street
 Jackson, Mississippi 39201

CODED

WATER WELL DRILLERS LOG

10-2 1980 McNeil Well Works Harrison
 date well completed firm name county well located

LANDOWNER: Edward Griffin
 Rt 3, Box 543 B
 Lymon Miss.
 (mailing address)

WELL LOCATION:
 sec. 30 T 6 N R 11 E
 1 miles W of Lymon
 (distance) (direction) (nearest town)

WELL PURPOSE: home
 (home, irrigation, municipal, industrial)

WELL COMPLETION DATA:

- (1) diameter (inches) 2"
- (2) total depth (feet) 480
- (3) static water level (feet) 60' below top of ground
- (4) casing PVC 470
 (material) (depth)
 If telescope see back.
- (5) screen 10' 1
 (length) (depth to top)
 2" elastic
 (size) (material)
- (6) pump 1 12
 (HP) (yield gpm)
 electric
 (type power)
- (7) electric log no
 (yes or no)
 (organization running log)
- (8) how well bottom plugged and mark

description of formations encountered	from to	
blue clay	0	20
mud sand	20	80
slush	80	110
sand - mud	110	160
white clay	160	200
slush	200	250
mud sand	250	310
blue mud	310	350
mud sand	350	410
fine sand	410	450
MCNEIL (10ml)	450	465
	465	480

CODED

DEPT. OF NATURAL RESOURCES
 BUREAU OF LAND & WATER RESOURCES

SEP - 7 1982

RECEIVED


DRILLERS REMARKS:

If well telescopes please sketch and show depths.

HARRISON

08-5-01

GROUND LEVEL

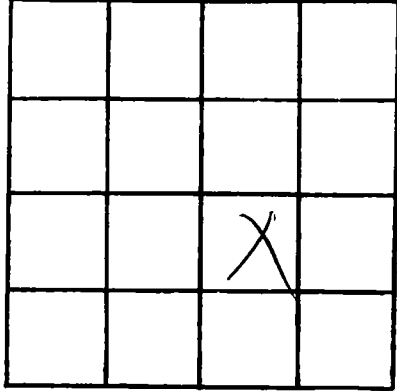

SECTION 30

Please indicate well location X.

ADDITIONAL INFORMATION

Lined area for additional information.

If more than one screen, show locations of each on sketch.