

MISSISSIPPI DEPARTMENT OF NATURAL RESOURCES

Bureau of Land and Water Resources

Southport Mall

P.O. Box 10631

Jackson, Mississippi 39209

WATER WELL DRILLERS LOG

CODED

Harrison
G377
10/6/82

Oct 16 1982 BRADEN PUMP & WELL SERVICE, INC HARRISON
date well completed firm name county well located

LANDOWNER:	description of formations encountered	from	to
<u>Charles Carter</u>			
<u>Rt 2, Box 85 Saucier, MS</u> (mailing address)	<u>SAND</u>	<u>40</u>	<u>50</u>
WELL LOCATION: sec. <u>28</u> T. <u>6</u> S. R. <u>11</u> W. <u>4</u> miles <u>SE</u> of <u>Saucier</u> (distance) (direction) (nearest town)	<u>CLAY</u>	<u>50</u>	<u>90</u>
WELL PURPOSE: <u>Home</u> (home, irrigation, municipal, industrial)	<u>SAND</u>	<u>90</u>	<u>95</u>
WELL COMPLETION DATA: (1) diameter (inches) <u>4" x 2"</u>	<u>CLAY</u>	<u>95</u>	<u>178</u>
(2) total depth (feet) <u>377</u>	<u>SAND</u>	<u>178</u>	<u>185</u>
(3) static water level (feet) <u>59</u> below above top of ground.	<u>CLAY</u>	<u>185</u>	<u>240</u>
(4) casing <u>PVC</u> , <u>367</u> , (material) (depth) <u>4" x 2"</u> if telescope see back. (size)	<u>SAND & CLAY</u>	<u>240</u>	<u>260</u>
(5) screen <u>10FT</u> , <u>367</u> (length) (depth to top) <u>2"</u> , <u>PVC</u> (size) (material)	<u>CLAY</u>	<u>260</u>	<u>300</u>
(6) pump <u>1.546</u> , <u>18</u> (HP) (yield gpm) <u>220 V 1ϕ</u> (type power)	<u>SAND & CLAY</u>	<u>300</u>	<u>320</u>
(7) electric log <u>No</u> (yes or no) (organization running log)	<u>SAND</u>	<u>320</u>	<u>377</u>
(8) how well bottom plugged <u>2" Sand Shuck</u>			<u>+</u>
DRILLERS REMARKS:			

CODED

DEPT. OF NATURAL RESOURCES
BUREAU OF LAND & WATER RESOURCES

OCT 25 1982

RECEIVED

If well telescopes please sketch and show depths.

GROUND LEVEL

4" PVC


245 FT

2" PVC

267 FT

277 FT

2" x 16 FT
PVC Screen

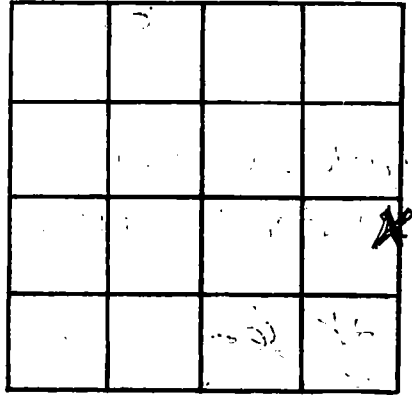

SECTION 28

Please indicate well location X.

ADDITIONAL INFORMATION

If more than one screen, show locations of each on sketch.